IREDELL COUNTY HEALTH DEPARTMENT

Authorization to Construct

STATESVILLE 704-878-5305 MOORESVILLE 704-664-5281

IMPROVEMENT PERMIT / ~~CERTIFICATE OF COMPLETION~~ / OPERATION PERMIT / EXISTING SYSTEM INSPECTION

PROPERTY DESCRIPTION NO. 25839 DATE 1/24/97 TAX MAP NO. 4648035097 Watershed: X Yes ☐ No

OWNER OR CONTRACTOR Mark Barker. PHONE: Business _____ Home 663-4048

ADDRESS 115-A Michigan Dr. Mooresville, NC. 28115

LOCATION 150 TR Bluefield Rd. TL Big bend around sharp curve on (L) to # 465

SUBDIVISION C L + T BLOCK / SECTION 12 LOT 36 LOT AREA .88Ac SITE CLASS. PS DESIGN FLOW 360 L.T.A.R. .3

Septic Tank: 1000 Gallons; STB 794 Date 2/6/98

Pump Tank: _____ Gallons; PT _____ Date _____

Pump Make: _____ Model _____ Serial No. _____

Nitrification Field: No Fields 1 Square Feet 900 Linear Feet * 300

No Lines ~~45~~ 5 Trench Width 36" Max Trench Bottom Depth 36" Gravel Depth SAND.

X New System ☐ Repair System Type: I, II, (III) IV, V, VI

System Description: *CH. PLASTIC

Repair System Description: PREF. PANELS.

Maintenance Agreement Required: ☐ Yes X No

X House/Mod. Home No. Bedrooms 3

☐ Mobile Home No. Bathrooms 2

☐ Business No. Employees ____

☐ Other _____


☐ Slab ☐ Crawl Space ☐ Basement w/plumbing ☐ Basement wo/plumbing

Water Supply: X Individual ☐ Community ☐ Public


Comments: 6/2/97 Changed to 5 lines @ 60'x3' Chambered plastic - Rwss.

Comments:

INITIAL SITE SKETCH

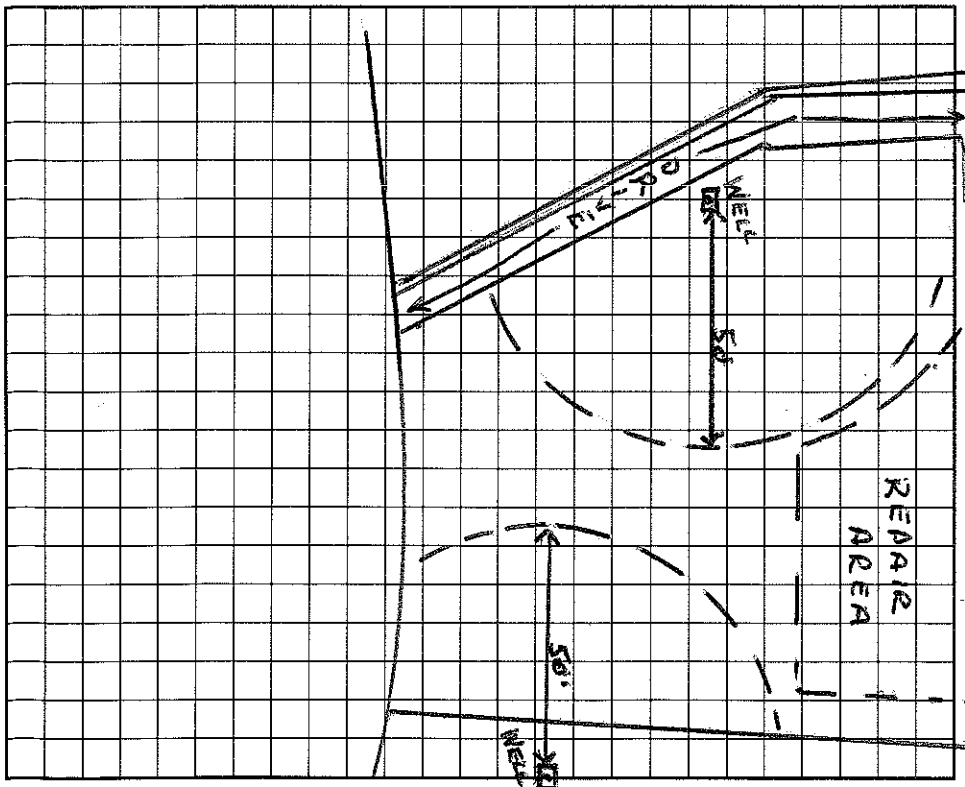

AS BUILT SKETCH

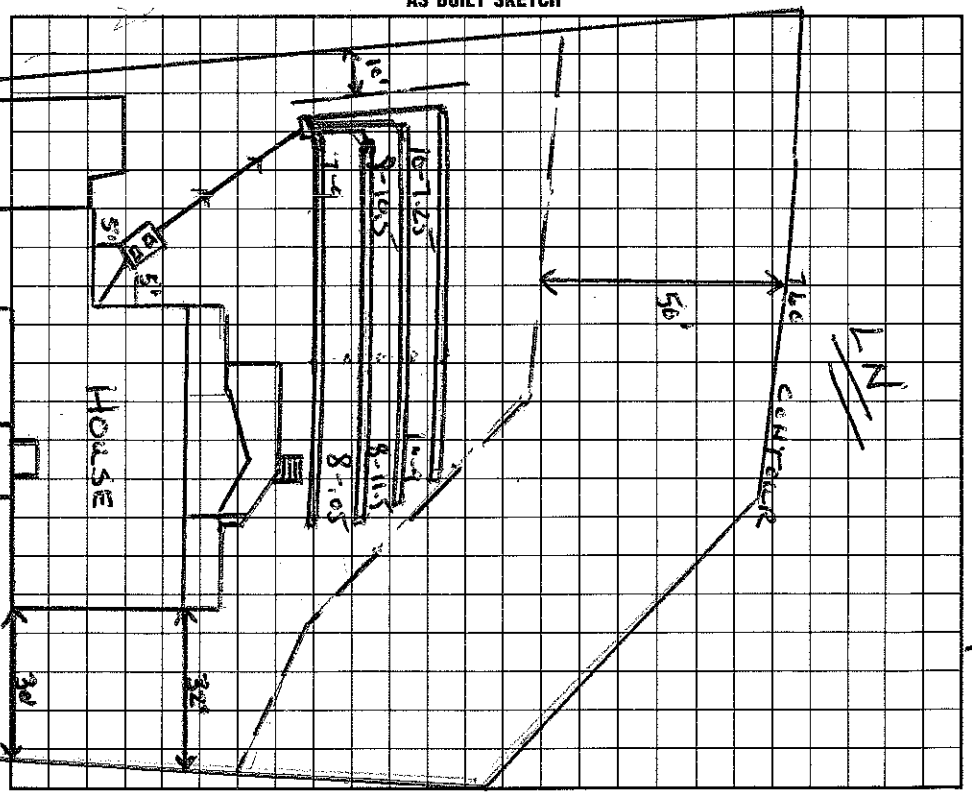

I understand that this permit can be suspended or revoked if any false information is supplied toward securing the permit/any unauthorized changes are made to the site/any unauthorized changes are made in the installation of the system. Improvement Permit is valid for 60 months from date of issuance.

Signed: * Mark Barker

Installed by: Tim Timmons

Improvement Permit by: Wesley Sparks R.S. date 1/24/97

Certificate of Completion by: Wesley Sparks R.S. date 3/26/98

~~Existing System Inspection~~ by: Wesley Sparks R.S. date 1/24/97

Operation Permit by: Wesley Sparks R.S. date 3/26/98

HEALTH DEPT. COPY: WHITE INSPECTION COPY (FINAL): GREEN OWNER COPY (FINAL): YELLOW INSPECTION COPY (INITIAL): PINK OWNER COPY (INITIAL): GOLD

IREDELL COUNTY HEALTH DEPARTMENT

Statesville Phone TR 3-7271 Mooresville Phone No. 664-528

PERMIT TO INSTALL SEPTIC TANK

Permit No. 209 Permit Date 8-23- 1973

Owner Mrs. James Campbell Address Mooresville

Installed By E. J. Ervin Address Mooresville


Location of Property out Cornelius Road To after I-77 Take next Paved Rd to right (1395) at end Turn right ¾ mi on left

Tank		Capacity		Length of Lines		Fixtures	
Block	( )	1000	(✓)	225'	(✓)	No. of Baths	(2)
Precast	(✓)	1250	( )	250'	( )	Dishwasher	(no)
		1500	( )	Other		Garbage Grdr.	(no)
		Other				Other Washing Machine	

NOTIFY HEALTH DEPARTMENT AT LEAST EIGHT HOURS BEFORE TANK IS TO BE INSPECTED.

Final Inspection 8-23- 1973 Approved (✓) Disapproved ( )

Remarks well next door

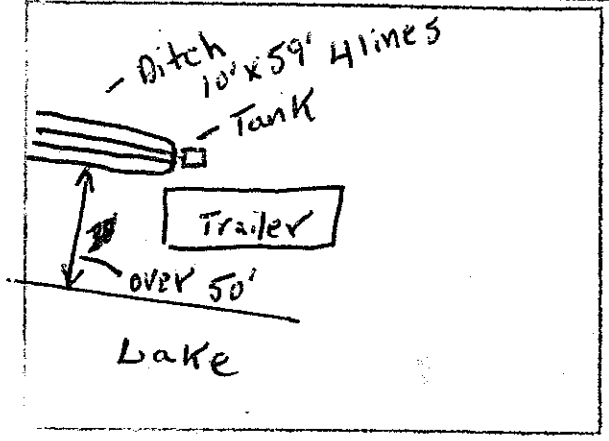

Sketch of Installation

J. C. Moore

Sanitarian