IREDELL COUNTY HEALTH DEPARTMENT

Statesville Office (704) 878-5305 Mooresville Office (704) 660-3625 PERMIT # 216725

IMPROVEMENT PERMIT / AUTHORIZATION TO CONSTRUCT / OPERATION PERMIT / EXISTING SYSTEM

PIN # 4648-03-8367.000

APPLICANT: Bryan Clodfelter Constr. APPLICANT ADDRESS: 1824 Triplett Rd. Mt. Ulla NC 28125

SITE ADDRESS: 484 Big Indian Ln. Mooresville NC PHONE: 704-663-4041 ALT. PHONE: 704-634-2506

SITE DIRECTIONS: Hwy 150 W, Rt Blackfield, Rt Big Indian, 1.5 mi. on R


SUBDIVISION: Indian Forest SECTION: — LOT # 5 LOT AREA: 1.5 Acre DESIGN FLOW: Ex. 360 GPD L.T.A.R.: Existing

Septic Tank	Existing	(gal)	STB		Date		☐ New System	☐ Repair	☐ Expansion	System Type: I	II	III	IV	V	VI	☑ Residence	No. Bedrooms 4.3
Pump Tank		(gal)	PT		Date		System Description: Existing Conventional - Gravity									☐ Business	No. Persons Ex. 6
Pump Make		Model			Serial #		Repair System Description: Same									☐ Other	No. Employees
# Nitrification Fields	Ex.	# Lines	Ex.		Linear Ft:	Ex.	Maintenance Agreement Required:		☐ YES	☒ NO						☐ Slab	☑ Crawl Space
Trench Width	Ex.	Max. Trench Bottom Depth	Ex.		Gravel Depth	Ex.	☑ GRAVITY		☐ PRESSURE							☐ Basement w/plumbing	☐ Basement w/o plumbing


Water Supply: ☑ Private ☐ Public ☐ Community

Comments / Conditions: Existing System Approved To Be Functionally & Time of Inspection. This Permit is for Proposed Detached Garage.

INITIAL SITE SKETCH

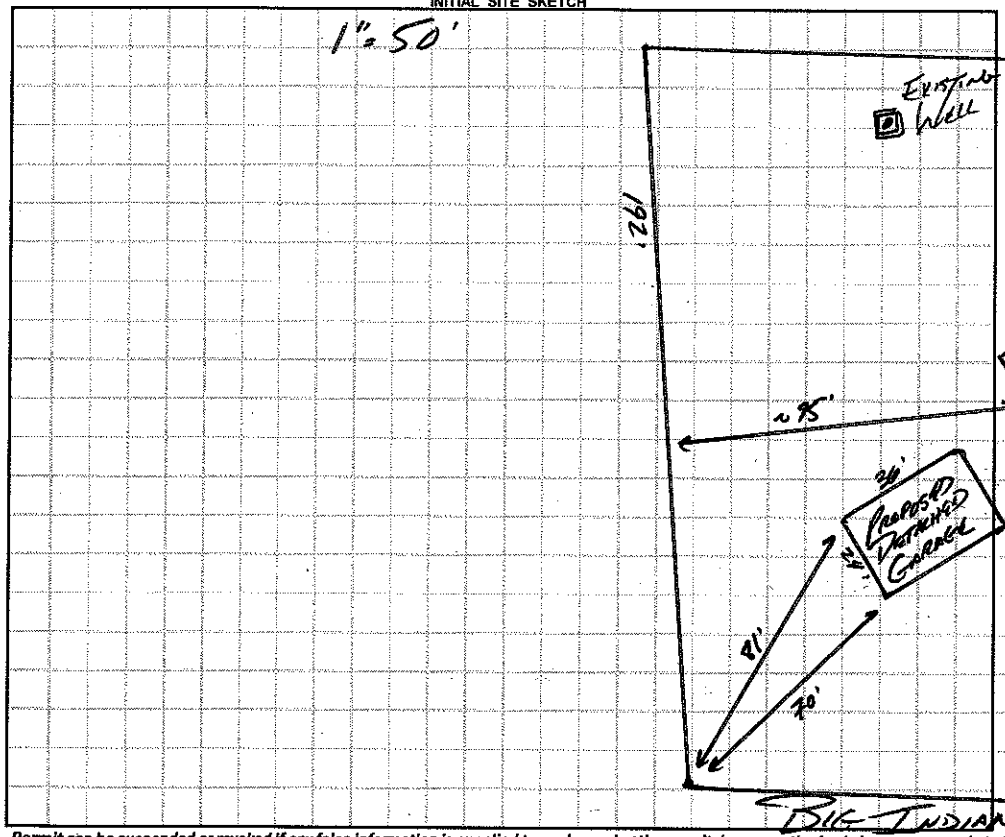

AS BUILT SKETCH

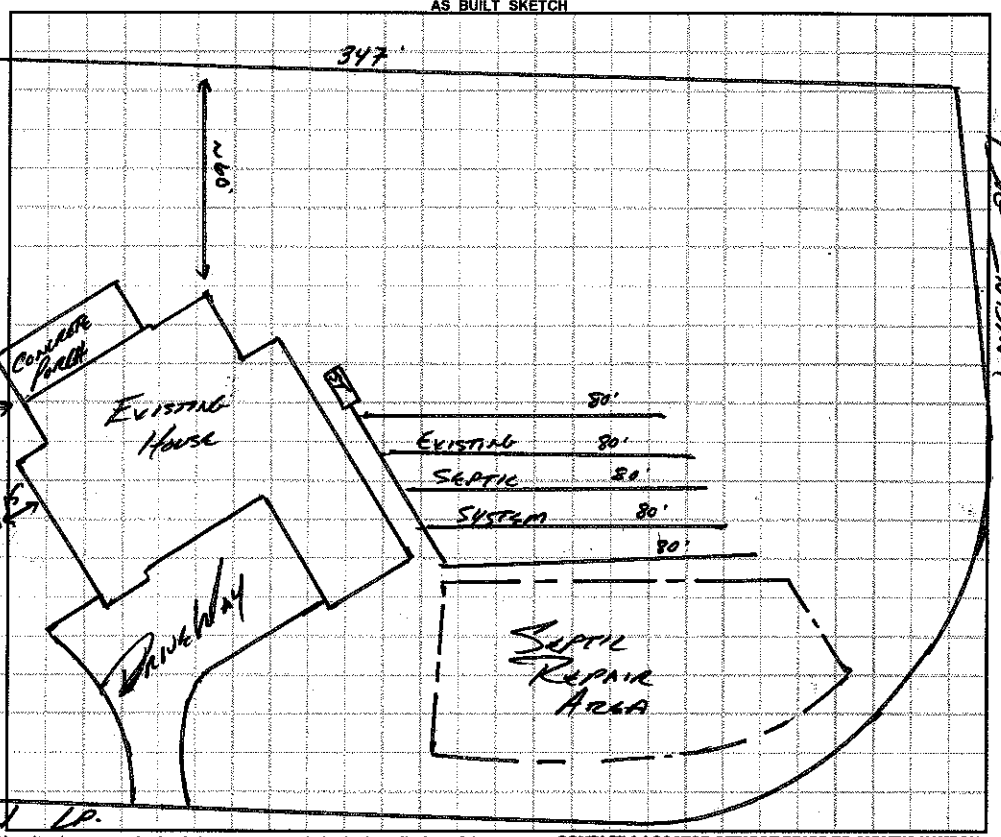

Permit can be suspended or revoked if any false information is supplied toward securing the permit / any unauthorized changes are made to the site / any unauthorized changes are made in the installation of the system. **CONTACT A LOCATOR SERVICE PRIOR TO ANY EXCAVATION**

☐ **IMPROVEMENT PERMIT** *with plat valid without expiration.* ☐ **IMPROVEMENT PERMIT** *with site plan valid for 60 mos.* ☐ **AUTHORIZATION TO CONSTRUCT** *valid for period equal to IMPROVEMENT PERMIT--not to exceed 60 mo.*

Owner / Applicant Signature: Bryan Clodfelter Date: 4/12/16 Installed by:

IMPROVEMENT PERMIT by: Date: OPERATION PERMIT by: Date:

AUTHORIZATION TO CONSTRUCT by: Date: Existing System Inspected by: Date: APPROVED MAR 27 2016

Health Dept. Copy - WHITE Applicant (Final Approval) - YELLOW Applicant (Conditional Approval) - PINK