IREDELL COUNTY HEALTH DEPARTMENT

Authorization to Construct

STATESVILLE 704-878-5305 | MOORESVILLE 704-664-5281

4648-03-9159

IMPROVEMENT PERMIT / ~~CERTIFICATE OF COMPLETION~~ / OPERATION PERMIT / EXISTING SYSTEM INSPECTION

PROPERTY DESCRIPTION NO. 22420 DATE 12/19/95 TAX MAP NO. 2P 6C 6 Watershed: [X] Yes [ ] No

OWNER OR CONTRACTOR Phillip Brent PHONE: Business _____ Home 662-6297

ADDRESS 137 Piney Meadows Ln. Mooresville, NC. 28115

LOCATION Bluefield Rd. TL Big Indian Tp. straight ground cover ~.2 mile on (R)

SUBDIVISION Indian Forest BLOCK / SECTION _____ LOT 6 LOT AREA ~1.5Ac SITE CLASS. P5 DESIGN FLOW 360 L.T.A.R. .3

Septic Tank: 1000 Gallons; STB 794 Date 5/7/96

Pump Tank: _____ Gallons; PT _____ Date _____

Pump Make: _____ Model _____ Serial No. 360

Nitrification Field: No Fields 1 Square Feet 1200 Linear Feet ~~400~~

No Lines 4 Trench Width 36" Max Trench Bottom Depth 36" Gravel Depth 12"

[X] New System [ ] Repair System Type: I, II, III, IV, V, VI

System Description: ~~Gravity Conventional~~ LPP

Repair System Description: Same

Maintenance Agreement Required: [ ] Yes [X] No

[ ] House/Mod. Home No. Bedrooms 3

[ ] ~~Mobile Home~~ No. Bathrooms 2

[ ] Business No. Employees _____

[ ] Other _____


[ ] Slab [X] Crawl Space [ ] Basement w/plumbing [ ] Basement wo/plumbing

Water Supply: [X] Individual [ ] Community [ ] Public


Comments: 4 @ 100' x 3' installed on contour of slope
Speed levelers required in Dist Box.

Comments:

INITIAL SITE SKETCH

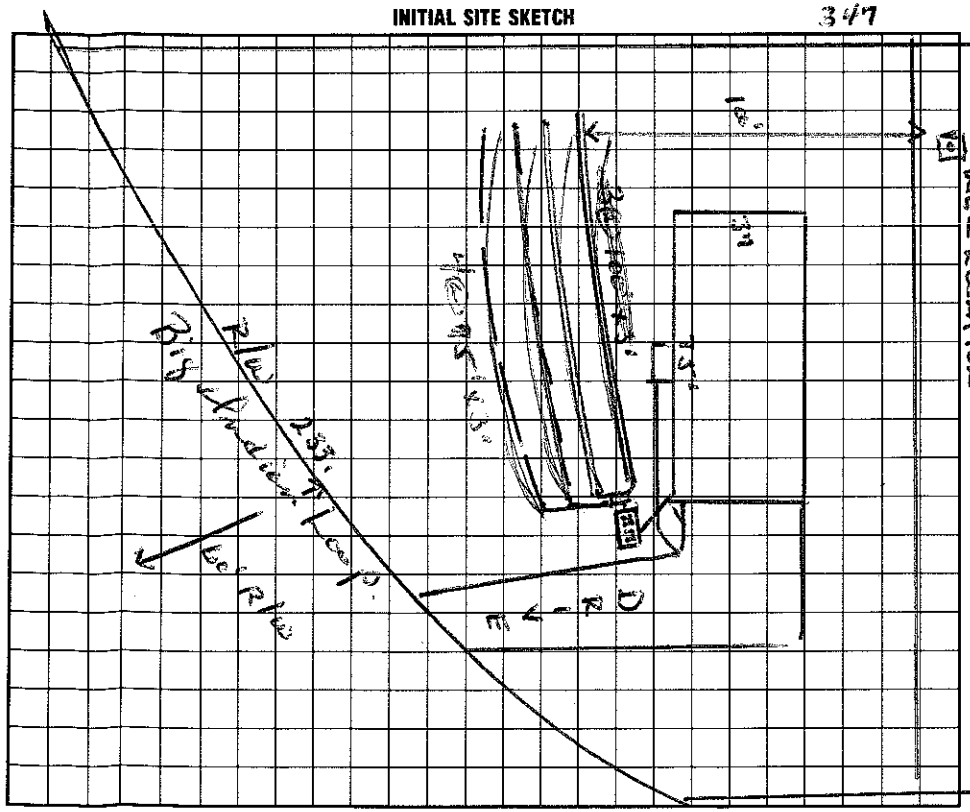

AS BUILT SKETCH

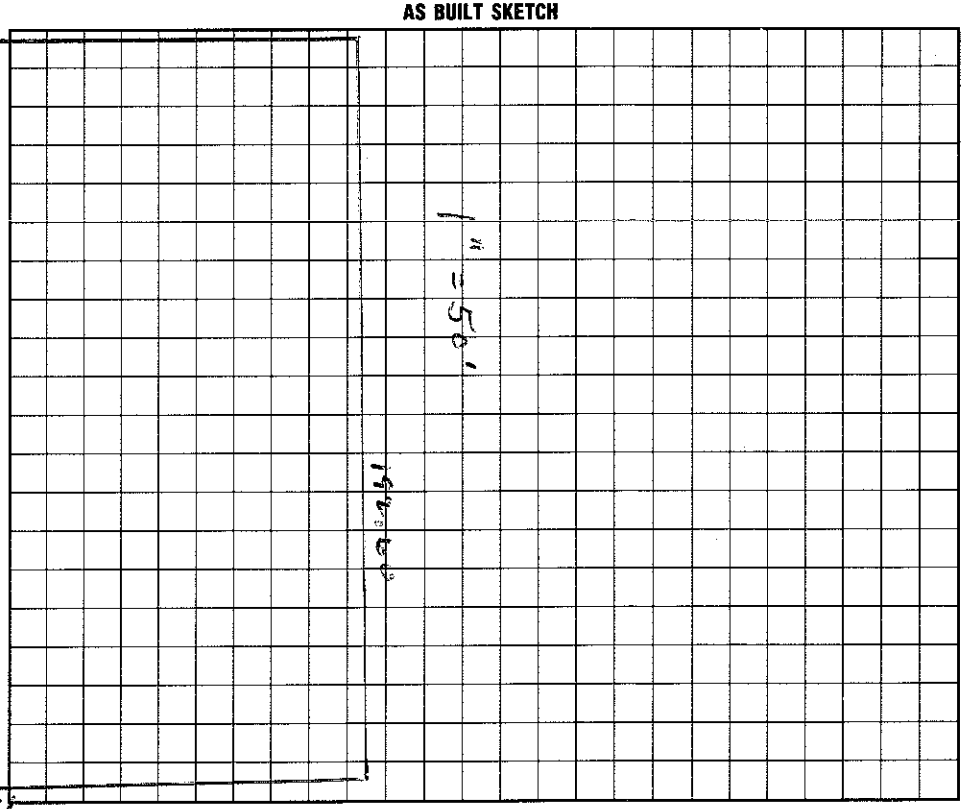

I understand that this permit can be suspended or revoked if any false information is supplied toward securing the permit/any unauthorized changes are made to the site/any unauthorized changes are made in the installation of the system.

Signed: Phillip Brent by Kim Vickers

Improvement Permit by: Wesley Sparks R.S. date 12/19/95

~~Authorization to Construct~~ Existing System Inspection by: Construct. Wesley Sparks R.S. date 12/19/95

Installed by: Larry Beam

Certificate of Completion by: _____ date _____

Operation Permit by: C. Ray Stearns date 7/23/96

HEALTH DEPT. COPY: WHITE | INSPECTION COPY (FINAL): GREEN | OWNER COPY (FINAL): YELLOW | INSPECTION COPY (INITIAL): PINK | OWNER COPY (INITIAL): GOLD