IREDELL COUNTY HEALTH DEPARTMENT

Statesville Office (704) 878-5305 Mooresville Office (704) 660-3625 PERMIT # 205707

IMPROVEMENT PERMIT / AUTHORIZATION TO CONSTRUCT / OPERATION PERMIT / EXISTING SYSTEM

PIN # 4648-05-1575

APPLICANT: LC PELLINGER APPLICANT ADDRESS: 1633 SHWY 16 STANLEY NC 28164

SITE ADDRESS: 208 MORGAN BLUFF RD - Mooresville PHONE: 704-309-6101 ALT. PHONE:

SITE DIRECTIONS: [redacted] CORNELIUS, TL MORGANS BLUFF, CEND

SUBDIVISION: PIRATES COVE SECTION: LOT # 21 LOT AREA: 1866 DESIGN FLOW: 480 L.T.A.R.: 1.3

Septic Tank 1000 (gal) STB 760 Date 6-17-15
Pump Tank (gal) PT Date
Pump Make Model Serial #
Nitrification Fields 1 # Lines 3 Linear Ft: 258'
Trench Width 36" Max. Trench Bottom Depth 30" Gravel Depth —

☒ New System ☐ Repair ☐ Expansion System Type: I II (III) IV V VI
System Description: EXISTING GRAVEL BED + 25%
Repair System Description: TS-1 PRETREAT 25%
Maintenance Agreement Required: ☐ YES ☒ NO
☒ GRAVITY ☐ PRESSURE

☒ Residence ☐ Business ☐ Other ☐ Slab ☒ Basement w/plumbing
No. Bedrooms 4 No. Persons 8 No. Employees
☐ Crawl Space ☐ Basement w/o plumbing

Water Supply: ☒ Private EXISTING ☐ Public ☐ Community

Comments / Conditions:

INITIAL SITE SKETCH

SEE PLAN BY ROLLANS SOIL & ENV. SERVICES

AS BUILT SKETCH

Permit can be suspended or revoked if any false information is supplied toward securing the permit / any unauthorized changes are made to the site / any unauthorized changes are made in the installation of the system. **CONTACT A LOCATOR SERVICE PRIOR TO ANY EXCAVATION**

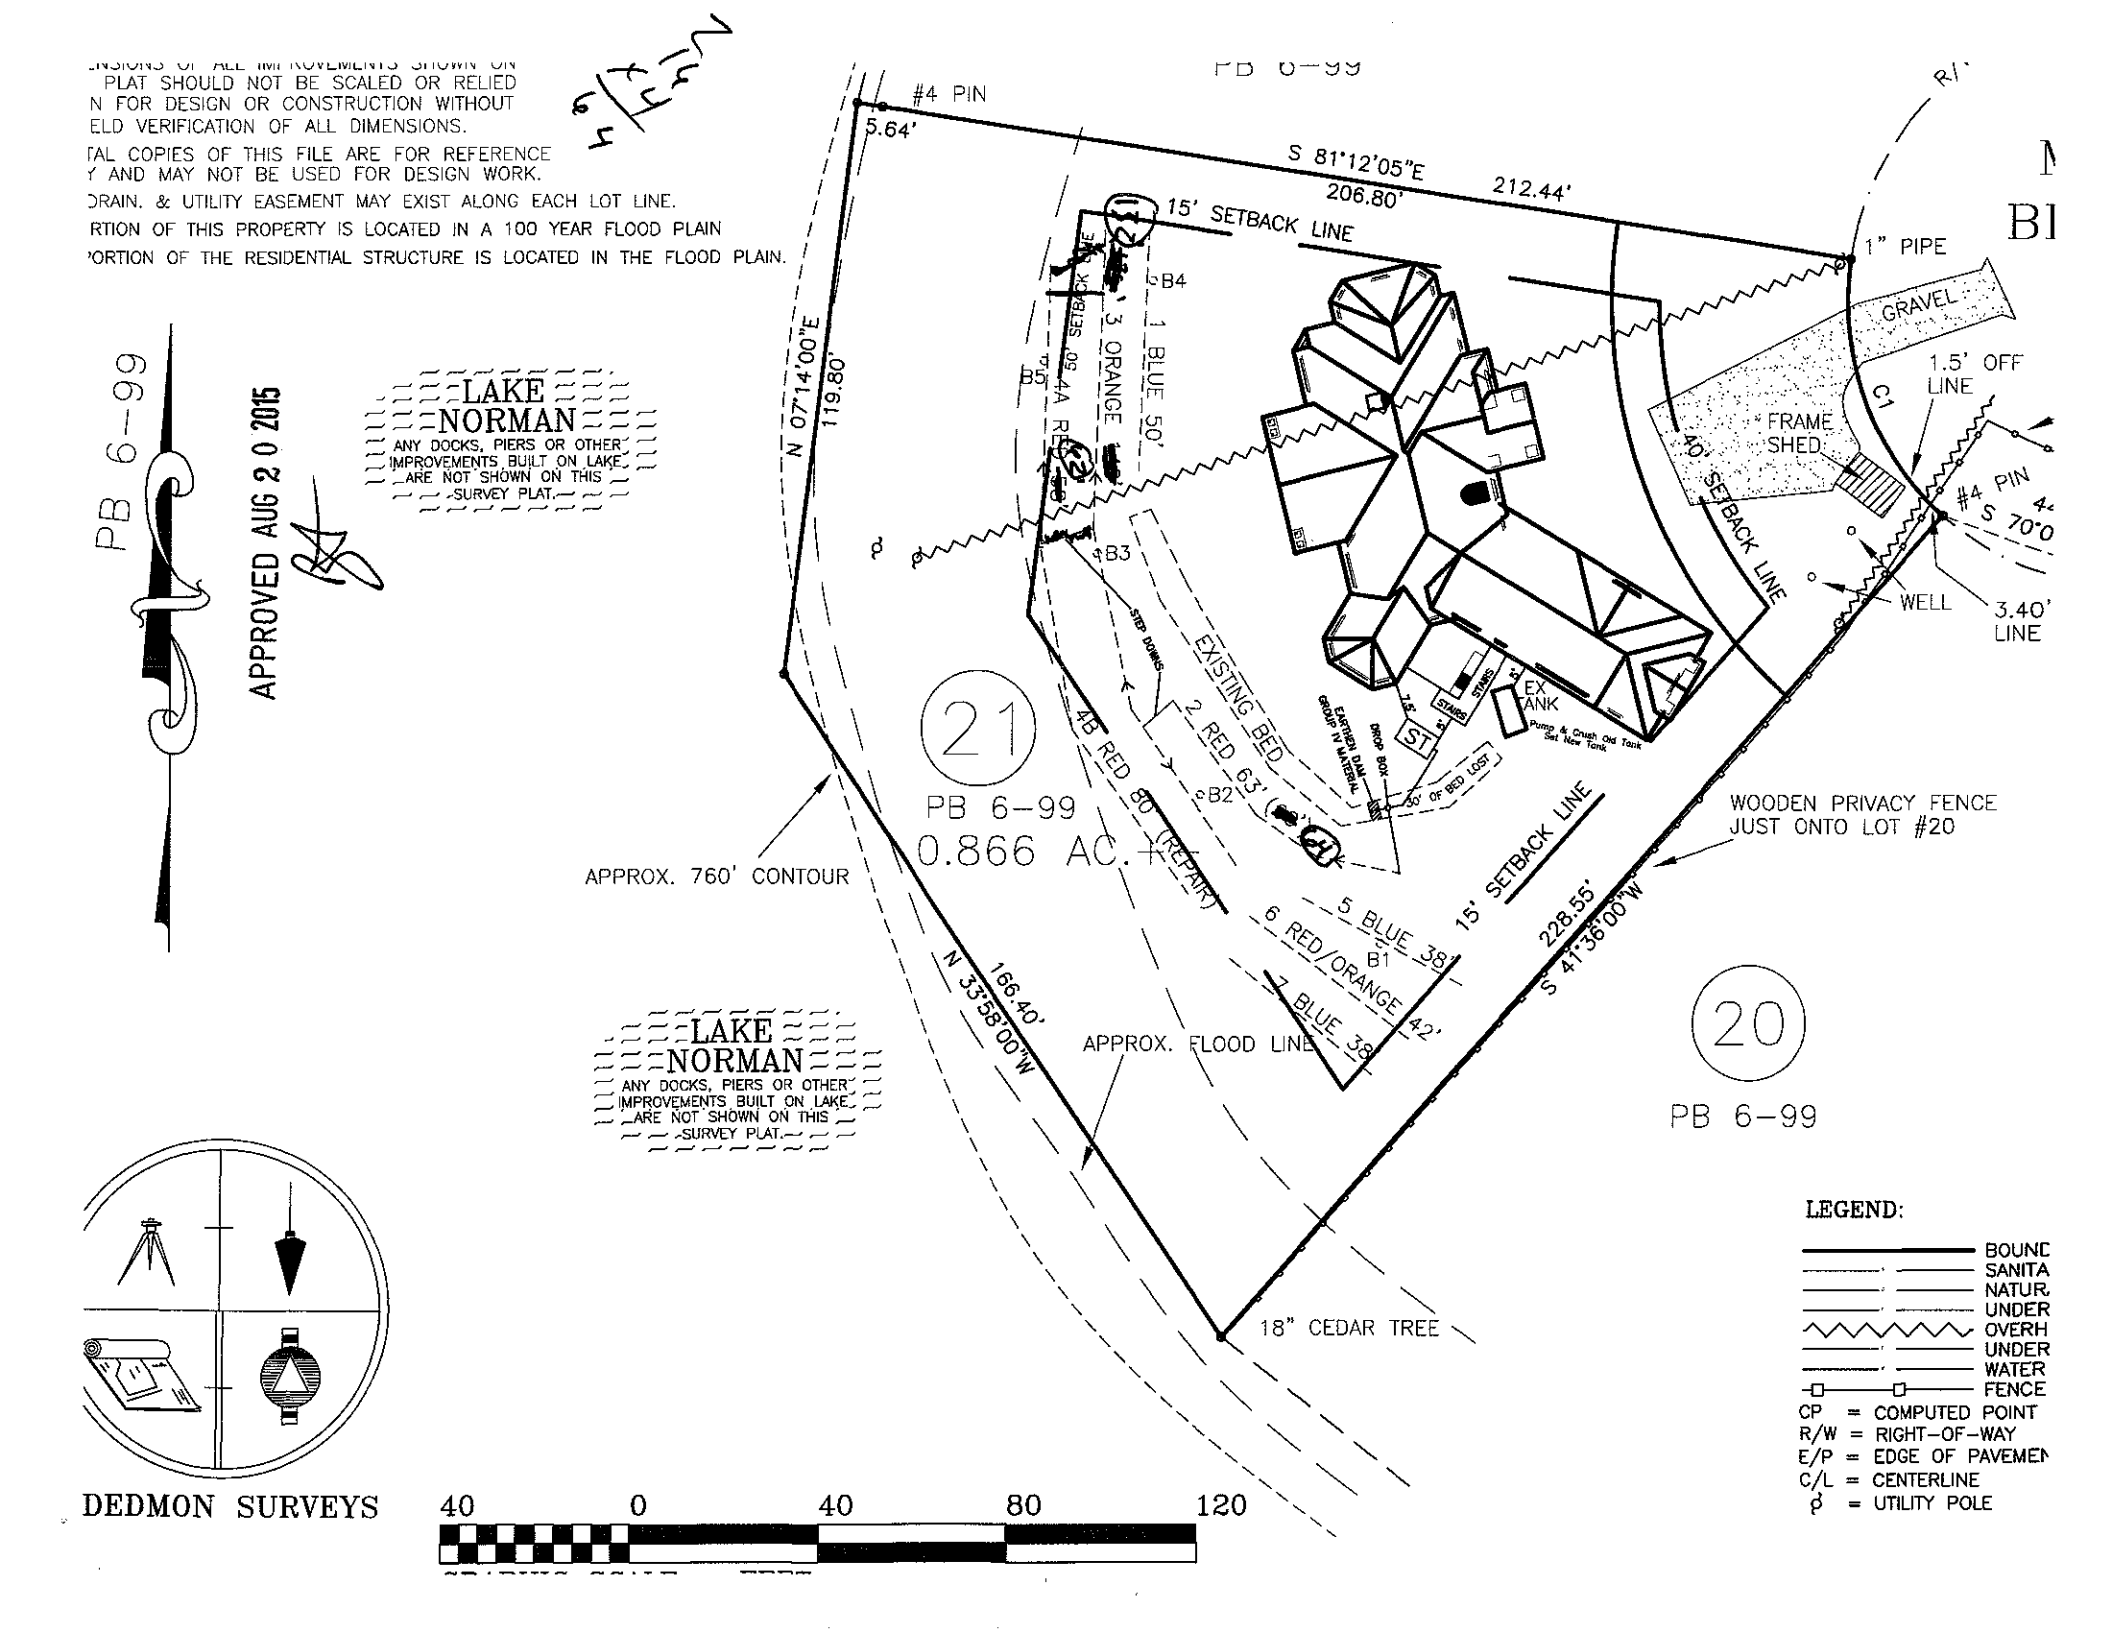
☐ **IMPROVEMENT PERMIT** *with plat valid without expiration.* ☐ **IMPROVEMENT PERMIT** *with site plan valid for 60 mos.* ☒ **AUTHORIZATION TO CONSTRUCT** *valid for period equal to IMPROVEMENT PERMIT--not to exceed 60 mo.*

Owner / Applicant Signature: Date: 11/4/15 Installed by:

IMPROVEMENT PERMIT by: Date: APPROVED AUG 20 2015 OPERATION PERMIT by: Date: APPROVED AUG 20 2015

AUTHORIZATION TO CONSTRUCT by: Date: APPROVED AUG 20 2015 Existing System Inspected by: Date:

Health Dept. Copy - WHITE Applicant (Final Approval) - YELLOW Applicant (Conditional Approval) - PINK


PLAT SHOULD NOT BE SCALED OR RELIED
N FOR DESIGN OR CONSTRUCTION WITHOUT
ELD VERIFICATION OF ALL DIMENSIONS.
TAL COPIES OF THIS FILE ARE FOR REFERENCE
Y AND MAY NOT BE USED FOR DESIGN WORK.
DRAIN. & UTILITY EASEMENT MAY EXIST ALONG EACH LOT LINE.
RTION OF THIS PROPERTY IS LOCATED IN A 100 YEAR FLOOD PLAIN
PORTION OF THE RESIDENTIAL STRUCTURE IS LOCATED IN THE FLOOD PLAIN.
PB 6-99
APPROVED AUG 2 0 2015
LAKE NORMAN
ANY DOCKS, PIERS OR OTHER IMPROVEMENTS BUILT ON LAKE ARE NOT SHOWN ON THIS SURVEY PLAT.
PB 6-99
#4 PIN
5.64'
S 81°12'05"E
206.80'
212.44'
15' SETBACK LINE
1" PIPE
GRAVEL
1.5' OFF LINE
C1
FRAME SHED
40' SETBACK LINE
#4 PIN
S 70°0
WELL
3.40' LINE
N 07°14'00"E
119.80'
B5
B4
B3
B2
B1
3 ORANGE 50'
1 BLUE 50'
4A RED 50'
STEP DOWNS
EXISTING BED
2 RED 63'
4B RED 80' (REPAIR)
EARTHEN DAM GROUP IV MATERIAL
DROP BOX
STAIRS
EX TANK
Pump & Crush Old Tank Set New Tank
21
PB 6-99
0.866 AC. ±
APPROX. 760' CONTOUR
WOODEN PRIVACY FENCE JUST ONTO LOT #20
15' SETBACK LINE
228.55'
S 41°36'00"W
5 BLUE 38'
6 RED/ORANGE 42'
7 BLUE 38'
N 33°58'00"W
166.40'
APPROX. FLOOD LINE
20
PB 6-99
18" CEDAR TREE
LAKE NORMAN
ANY DOCKS, PIERS OR OTHER IMPROVEMENTS BUILT ON LAKE ARE NOT SHOWN ON THIS SURVEY PLAT.
LEGEND:
BOUND
SANITA
NATUR
UNDER
OVERH
UNDER
WATER
FENCE
CP = COMPUTED POINT
R/W = RIGHT-OF-WAY
E/P = EDGE OF PAVEMEN
C/L = CENTERLINE
℘ = UTILITY POLE
DEDMON SURVEYS
40 0 40 80 120