IREDELL COUNTY HEALTH DEPARTMENT

662-2345

STATESVILLE 704-878-5305 MOORESVILLE 704-664-5281

IMPROVEMENT PERMIT / AUTHORIZATION TO CONSTRUCT / OPERATION PERMIT / EXISTING SYSTEM INSPECTION

PERMIT# 077427 PIN# 4648-06-7238

OWNER OR CONTRACTOR MICHAEL NANNEY DATE 11/04/98

ADDRESS 334 ERVIN RD · MOORESVILLE · NC 28117 PHONE: Business — Home —

LOCATION CORNELIUS RD - TL MORGAN BLUFF - ON LT

SUBDIVISION PIRATES COVE BLOCK / SECTION — LOT 41 LOT AREA — SITE CLASS. PS DESIGN FLOW 480 L.T.A.R. .3

Septic Tank: 1000 Gallons; STB 794 Date 10/16/98
Pump Tank: — Gallons; PT — Date —
Pump Make: — Model — Serial No. —
Nitrification Field: No Fields 1 Square Feet 1200 Linear Feet 400
No Lines ~~3~~ 4 Trench Width 36" Max Trench Bottom Depth 36" Gravel Depth N/A

☑ New System ☐ Repair System Type: I, II, (III), IV, V, VI
System Description: GRAVITY CHAMBERS OR HOS
Repair System Description: PUMP PANEL
Maintenance Agreement Required: ☐ Yes ☑ No

☐ House/Mod. Home No. Bedrooms 4
☐ Mobile Home No. Bathrooms 4
☐ Business No. Employees —
☐ Other —
☐ Slab ☐ Crawl Space ☑ Basement w/plumbing ☐ Basement wo/plumbing


Water Supply: ☑ Individual ☐ Public ☐ Community

Comments/Conditions:


Comments/Conditions: FILTER INSTALLED. Installed 5 Lines 86' x 3' Ch. Plastic

1" = 60'

INITIAL SITE SKETCH

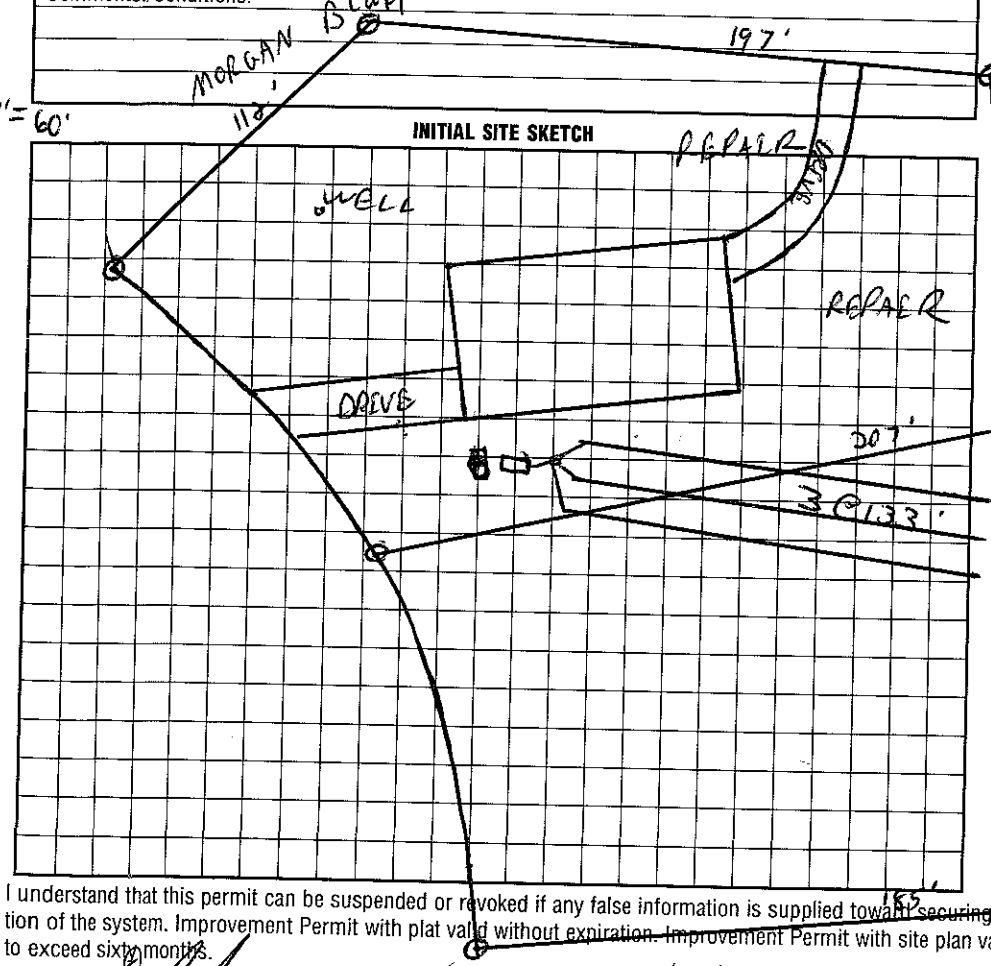

AS BUILT SKETCH

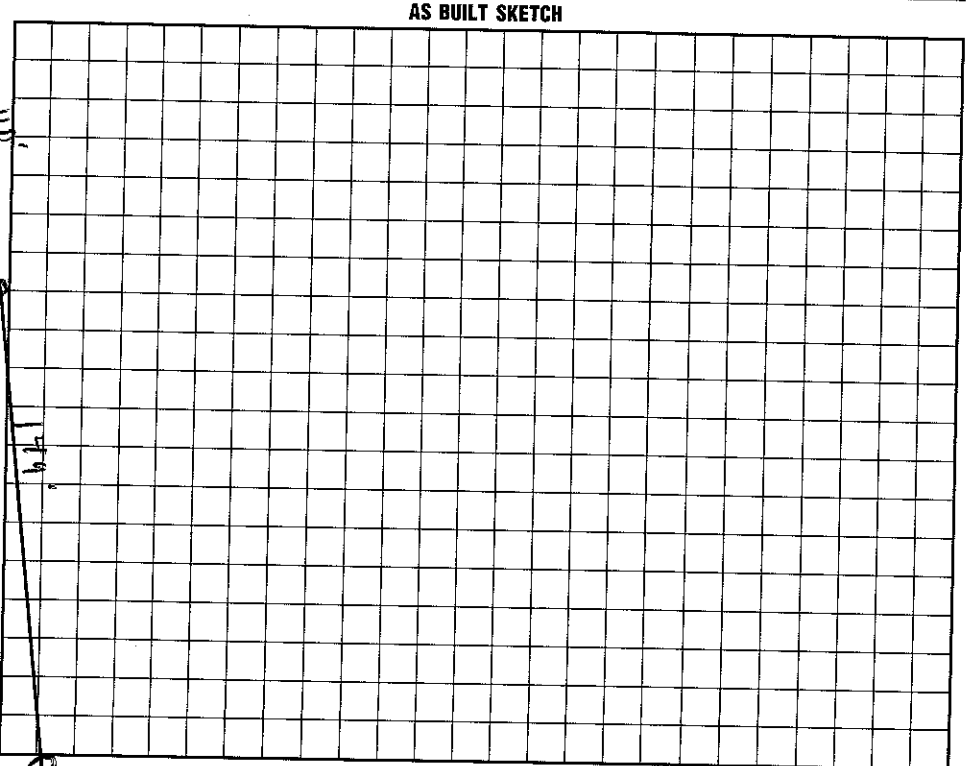

I understand that this permit can be suspended or revoked if any false information is supplied toward securing the permit/any unauthorized changes are made to the site/any unauthorized changes are made in the installation of the system. Improvement Permit with plat valid without expiration. Improvement Permit with site plan valid for sixty months. Authorization to Construct is valid for a period equal to that of Improvement Permit – not to exceed sixty months.

Signed: [signature] 11/6/98 date —

Improvement Permit by: [signature] RS date 11/10/98

Authorization to Construct by: [signature] RS date 11/10/98

Installed by: F I Erwin

Operation Permit by: Wesley Sparks RS date 1/5/00

Existing System Inspection by: — date —

HEALTH DEPT. COPY: WHITE INSPECTION COPY (FINAL): GREEN OWNER COPY (FINAL): YELLOW INSPECTION COPY (INITIAL): PINK OWNER COPY (INITIAL): GOLD