IREDELL COUNTY HEALTH DEPARTMENT

STATESVILLE 704-878-5305 — MOORESVILLE 704-664-5281

D Addition

IMPROVEMENT PERMIT / AUTHORIZATION TO CONSTRUCT / OPERATION PERMIT / EXISTING SYSTEM INSPECTION

PERMIT# 111540 PIN# 4648-06-7733 DATE 3-7-03

OWNER OR CONTRACTOR Caden Construction / Davis Stewart PHONE: Business 309-6810 (Shawn) Home

ADDRESS P.O. Box 1281 Davidson, NC

LOCATION Perth Rd N. TR Cornelius TR Morgan Bluff lot on left

SUBDIVISION PiratesCove BLOCK / SECTION LOT 37 LOT AREA .45 Acre SITE CLASS. PS DESIGN FLOW 360gpd L.T.A.R. .3

Septic Tank: 1000 Gallons; STB Date

Pump Tank: Gallons; PT Date

Pump Make: Model Serial No.

Nitrification Field: No Fields 1 Square Feet 900' Linear Feet 300'

No Lines 5@60' Trench Width 36" Max Trench Bottom Depth 36" Gravel Depth N/A

X New System ☐ Repair System Type: I, II, III, IV, V, VI

System Description: Existing Gravity – 25% Reduction

Repair System Description:

Maintenance Agreement Required: ☐ Yes X No

X House/Mod: Home (Total) No. Bedrooms 3

☐ Mobile Home No. Bathrooms 3.5

☐ Business No. Employees

X Other Detached garage


☐ Slab ☐ Crawl Space ☐ Basement w/plumbing ☐ Basement w/o plumbing

Water Supply: X Individual ☐ Public ☐ Community


Comments/Conditions: Existing Septic System appears to be functioning okay at time of inspection, No problems noticed.

Comments/Conditions: Building detached garage with bathroom. Total number of bedrooms will remain as 3, (Existing house has 2 bedrooms – drawings attached)

INITIAL SITE SKETCH Scale 1:40

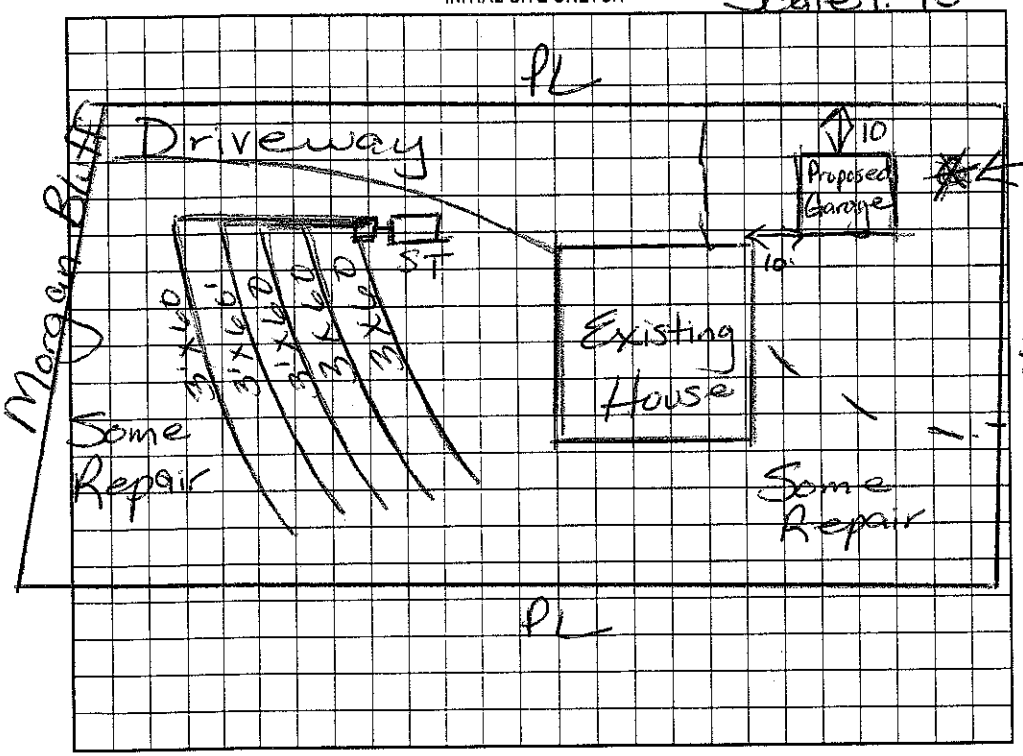

AS BUILT SKETCH

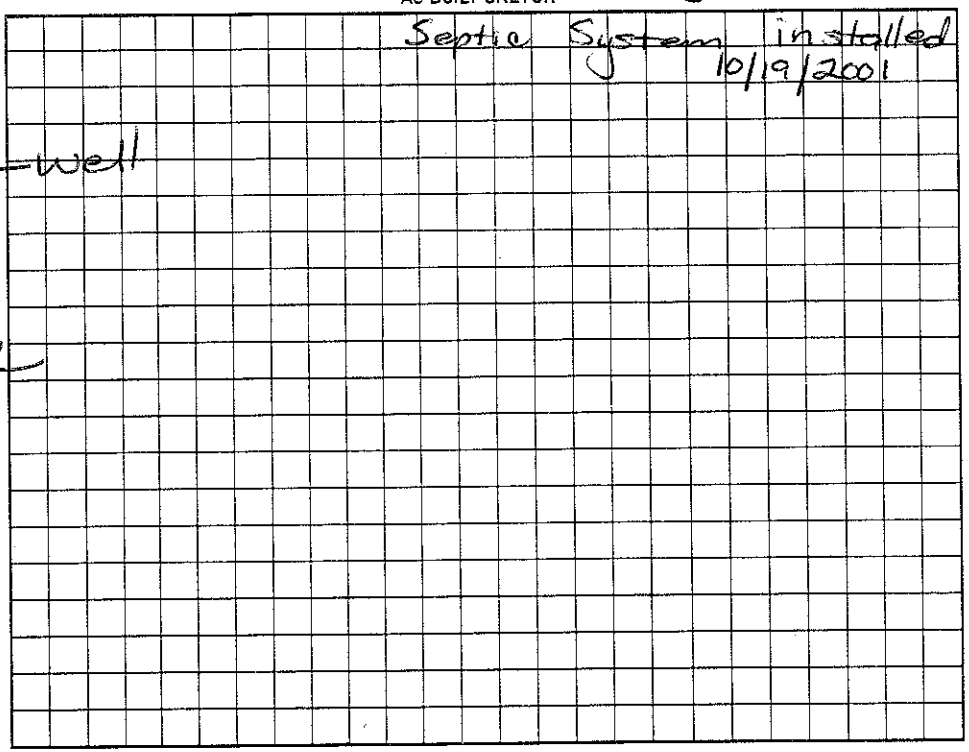

Permit can be suspended or revoked if any false information is supplied toward securing the permit/any unauthorized changes are made to the site/any unauthorized changes are made in the installation of the system. Improvement Permit with plat valid without expiration. Improvement Permit with site plan valid for sixty months. Authorization to Construct is valid for a period equal to that of Improvement Permit – not to exceed sixty months.

Signed: X Carolyn Stewart date 3/5/03

Improvement Permit by: Maria H. Dobson RS date 3/10/03

Authorization to Construct by: date

Installed by:

Operation Permit by: date

Existing System Inspection by: Maria H. Dobson RS date 3/10/03

HEALTH DEPT. COPY: WHITE OWNER COPY (FINAL): YELLOW OWNER COPY (INITIAL): PINK

IREDELL COUNTY HEALTH DEPARTMENT

STATESVILLE 704-878-5305 50.00 Paid MOORESVILLE 704-664-5281 1100

IMPROVEMENT PERMIT / AUTHORIZATION TO CONSTRUCT / OPERATION PERMIT / EXISTING SYSTEM INSPECTION

PERMIT# 095042 PIN# 4648067733 Shaun's Mobile DATE 5-17-01

OWNER OR CONTRACTOR Ogden Construction PHONE: Business 309-6810 Home

ADDRESS P.C. Box 1281 Davidson, NC 28036

LOCATION Perth Rd N TR Cornelius TR Morgan Bluff on left

SUBDIVISION Pirates Cove BLOCK / SECTION LOT 37 LOT AREA .46 Acre SITE CLASS. PS DESIGN FLOW 360gpd L.T.A.R. .37

Septic Tank: 1000 Gallons: STB 1012 Date 8-6-01
Pump Tank: Gallons: PT Date
Pump Make: Model Serial No.
Nitrification Field: No Fields 1 Square Feet 900' Linear Feet 300'
No Lines 5 at 60' Trench Width 36" Max Trench Bottom Depth 36"

X New System ☐ Repair System Type: I. II (III) IV. V. VI
System Description: Gravity -25% Reduction
Repair System Description: * Partial Repair
Maintenance Agreement Required: ☐ Yes ☒ No
Gravel Depth
☐ Slab ☐ Crawl Space ☒ Basement w/plumbing ☐ Basement wo/plumbing


☒ House/Mod. Home No. Bedrooms 3
☐ Mobile Home No. Bathrooms 2.5
☐ Business No. Employees
☐ Other

Water Supply: ☒ Individual ☐ Public ☐ Community


Comments:/Conditions: Keep Septic System at least 10' From PL & 50' From any Well. If Septic System upgradient of basement (or trench above foundation drain thus 25' Setback). If side gradient 15'.

Comments:/Conditions: * Lot deeded prior to 1983.
* Okay to use "Drop boxes" instead of Distribution boxes.
Filter installed

INITIAL SITE SKETCH Scale 1:40'

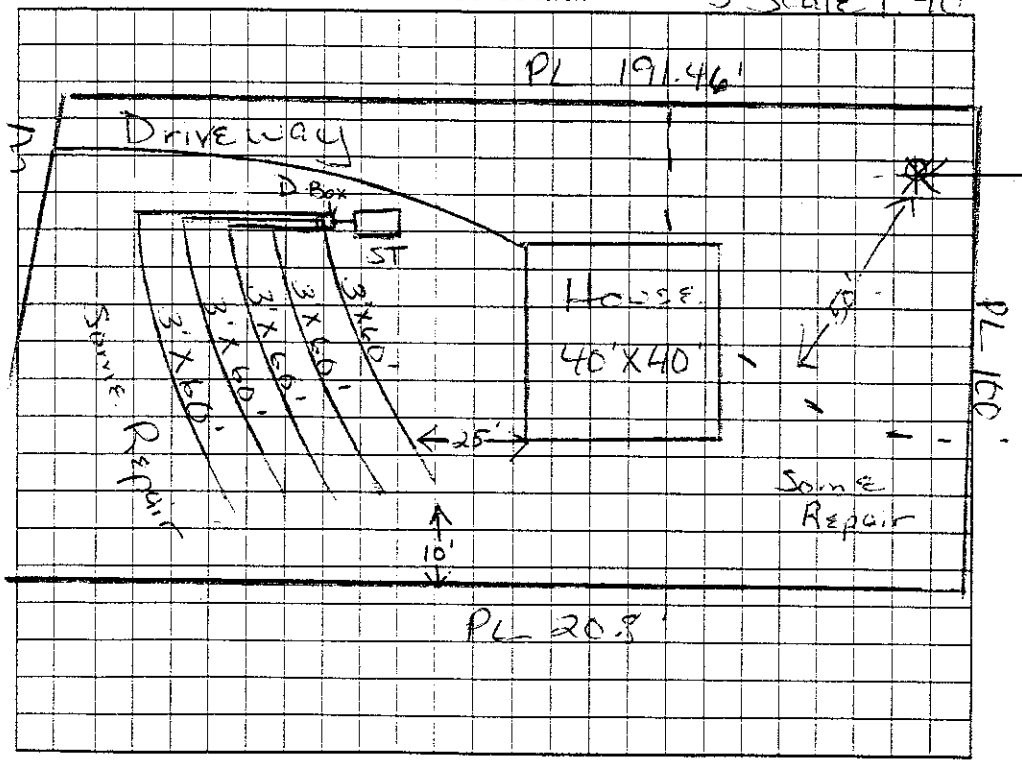

AS BUILT SKETCH

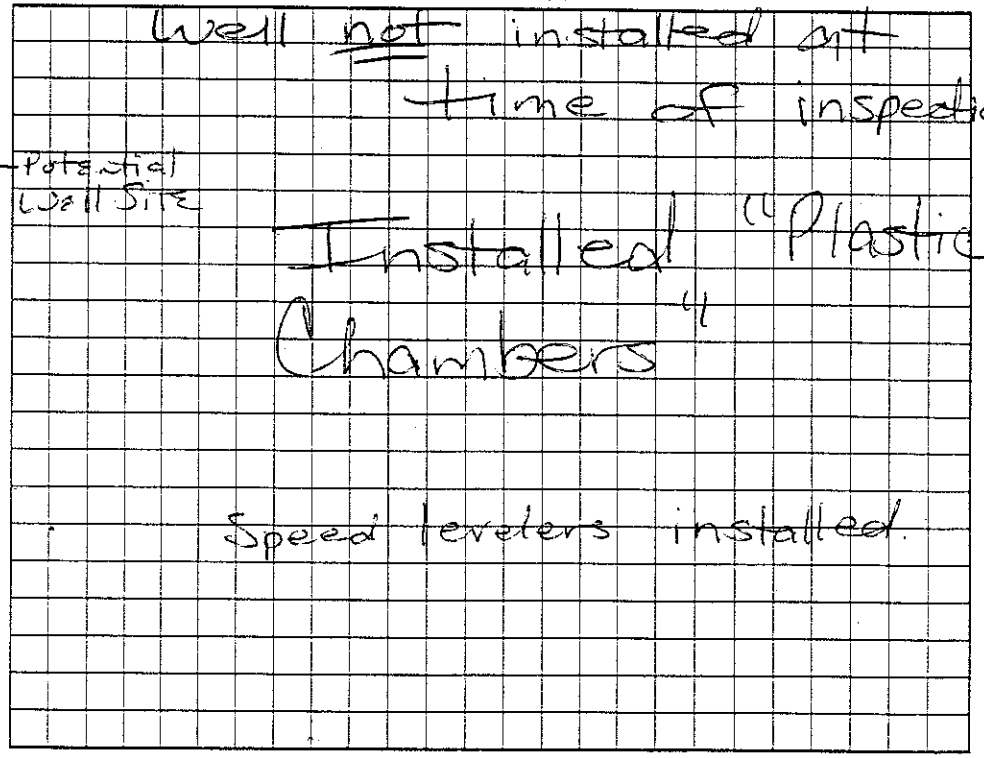

Permit can be suspended or revoked if any false information is supplied toward securing the permit/any unauthorized changes are made to the site/any unauthorized changes are made in the installation of the system. Improvement Permit with plan valid without expiration. Improvement Permit with site plan valid for sixty months. Authorization to Construct is valid for a period equal to that of Improvement Permit - not to exceed sixty months.

Signed: L. Allen Ogden date 5-22-01 Installed by: Richard Abernathy

ment Permit by: Maria H. H. Tatum RS date 5/17/2001 Operation Permit by: Maria H. H. Tatum RS date 10/19/2001

ation to Construct by: Maria H. H. Tatum RS date 5/17/2001 Existing System Inspection by: date