IREDELL COUNTY HEALTH DEPARTMENT

STATESVILLE 704-878-5305 50.00 Paid MOORESVILLE 704-664-5281 11600

IMPROVEMENT PERMIT / AUTHORIZATION TO CONSTRUCT / OPERATION PERMIT / EXISTING SYSTEM INSPECTION

PERMIT# 095042 PIN# 4648-06-7733 Shaun's Mobile DATE 5-17-01

OWNER OR CONTRACTOR Ogden Construction PHONE: Business 309-6810 Home

ADDRESS P.O. Box 1281 Davidson, NC 28036

LOCATION Perth Rd N TR Cornelius TR Morgan Bluff on left

SUBDIVISION Pirates Cove BLOCK / SECTION LOT 37 LOT AREA .46 Acre SITE CLASS. PS DESIGN FLOW 360gpd L.T.A.R. .3+

Septic Tank: 1000 Gallons; STB 1012 Date 8-6-01
Pump Tank: Gallons; PT Date
Pump Make: Model Serial No.
Nitrification Field: No Fields 1 Square Feet 900' Linear Feet 300'
No Lines 5 at 60' Trench Width 36" Max Trench Bottom Depth 36"

[X] New System [ ] Repair System Type: I, II, III, IV, V, VI
System Description: Gravity -25% Reduction
Repair System Description: * Partial Repair
Maintenance Agreement Required: [ ] Yes [X] No


[X] House/Mod. Home No. Bedrooms 3
[ ] Mobile Home No. Bathrooms 2.5
[ ] Business No. Employees
[ ] Other
[ ] Slab [ ] Crawl Space [X] Basement w/plumbing [ ] Basement wo/plumbing

Water Supply: [X] Individual [ ] Public [ ] Community

Comments/Conditions: Keep Septic System at least 10' from PL & 50' from any well. If Septic System upgradient of basement (or trench above foundation drain) then 25' setback. If side gradient 15'.

Comments/Conditions: * Lot deeded prior to 1983.
* Okay to use "Drop boxes" instead of Distribution boxes
Filter installed

INITIAL SITE SKETCH Scale 1:40'

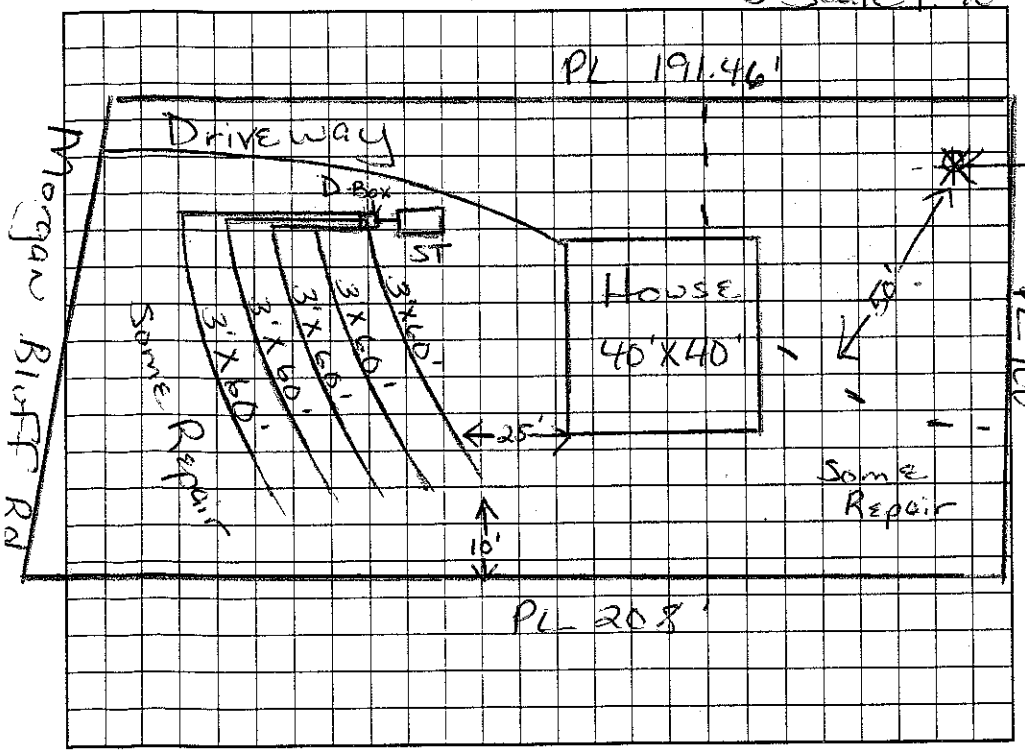

AS BUILT SKETCH

Well not installed at time of inspection

Installed 4" Plastic Chambers

Speed levelers installed.

Permit can be suspended or revoked if any false information is supplied toward securing the permit/any unauthorized changes are made to the site/any unauthorized changes are made in the installation of the system. Improvement Permit with plat valid without expiration. Improvement Permit with site plan valid for sixty months. Authorization to Construct is valid for a period equal to that of Improvement Permit - not to exceed sixty months.

Signed: L. Shaun Ogden date 5-22-01 Installed by: Richard Abernathy.

Improvement Permit by: Maria H. Tolson RS date 5/17/2001 Operation Permit by: Maria H. Tolson RS date 10/19/2001

Authorization to Construct by: Maria H. Tolson RS date 5/17/2001 Existing System Inspection by: date

HEALTH DEPT. COPY: WHITE OWNER COPY (FINAL): YELLOW OWNER COPY (INITIAL): PINK