IREDELL COUNTY HEALTH DEPARTMENT

STATESVILLE 704-878-5305 MOORESVILLE 704-664-5281

IMPROVEMENT PERMIT / CERTIFICATE OF COMPLETION / OPERATION PERMIT / EXISTING SYSTEM INSPECTION

PROPERTY DESCRIPTION NO. 21971 DATE 9/12/95 TAX MAP NO. 25 2A 35 Watershed: [X] Yes [ ] No

OWNER OR CONTRACTOR Q Lee Sowell PHONE: Business 4648-06-7975 Home 663-1217

ADDRESS 134 Morgan Bluff Rd.

LOCATION Morgan Bluff on R 2nd house off the sharp curve

SUBDIVISION Pirates Cove BLOCK / SECTION LOT 35 LOT AREA 130x152 SITE CLASS. PS DESIGN FLOW 480 L.T.A.R. .3

Septic Tank: 1000 Gallons; STB 794 Date 12/22/95
Pump Tank: Gallons; PT Date
Pump Make: Model Serial No. 500
Nitrification Field: No Fields 1 Square Feet 1600 Linear Feet ~~X~~
No Lines 4 Trench Width 36" Max Trench Bottom Depth 33" Gravel Depth N/A

[X] New System [ ] Repair System Type: I II III IV, V, VI
System Description: Gravity INFILTRATER
Repair System Description: Presser Panel
Maintenance Agreement Required: [ ] Yes [X] No


[X] House/Mod. Home No. Bedrooms 4
[ ] Mobile Home No. Bathrooms 3
[ ] Business No. Employees
[ ] Other
[ ] Slab [X] Crawl Space [ ] Basement w/plumbing [ ] Basement wo/plumbing

Water Supply: [X] Individual [ ] Community [ ] Public

Comments: + 25% reduction for infiltrator use

Comments: installer used wrong drainfield material - had to add 1 - 100' x 3 trainline and reconstruct trenches 1 and 4 to proper grade. AWS

INITIAL SITE SKETCH

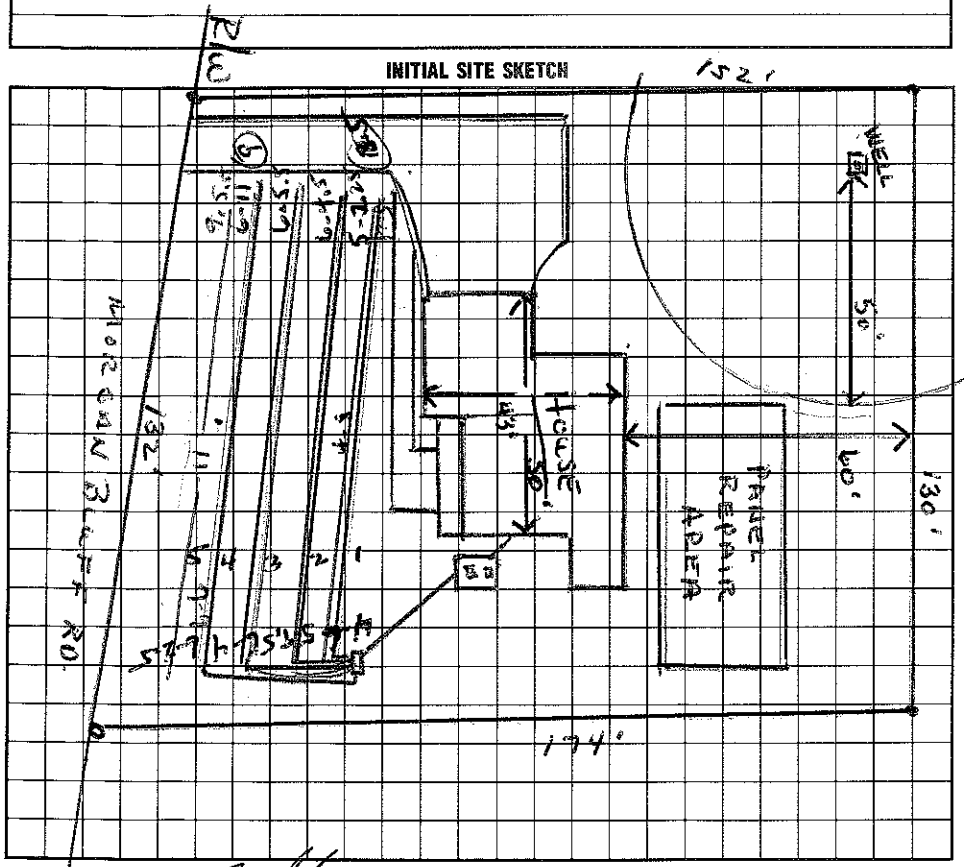

AS BUILT SKETCH

Type 2 installation - AWS 11/10/61

I understand that this permit can be suspended or revoked if any false information is supplied toward securing the permit/an, unauthorized changes are made to the site/any unauthorized changes are made in the installation of the system.

Signed:

Improvement Permit by: Wesley Sparks RS. date 9/12/95

Existing System Inspection by: date

Installed by: A Carolina Grading

Certificate of Completion by: Wesley Sparks RS date 2/23/96

Operation Permit by: Wesley Sparks RS date 2/29/96

HEALTH DEPT. COPY: WHITE INSPECTION COPY (FINAL): GREEN OWNER COPY (FINAL): YELLOW INSPECTION COPY (INITIAL): PINK OWNER COPY (INITIAL): GOLD