IREDELL COUNTY HEALTH DEPARTMENT

704-878-5305 MOORESVILLE 704-664-5281

IMPROVEMENT PERMIT / AUTHORIZATION TO CONSTRUCT / OPERATION PERMIT / EXISTING SYSTEM INSPECTION

4:00

PERMIT# 10484120 PIN# 4648069680 DATE 3-6-2002

OWNER OR CONTRACTOR Shaun Ogden (Bill Mclain) PHONE: Business 309-6810 Home

ADDRESS P.O. Box 1280 Davidson, NC 28036

LOCATION Hwy 21N TL Cornelius Rd TL Blackbeard Ln

SUBDIVISION Pirates Cove BLOCK / SECTION LOT 7 LOT AREA 20,000 sq.ft SITE CLASS. PS DESIGN FLOW 360gpd L.T.A.R. .3

Septic Tank: 1000 Gallons; STB 1012 Date 3-23-02

Pump Tank: Gallons; PT Date

Pump Make: Model Serial No.

Nitrification Field: No Fields 1 Square Feet 1200' Linear Feet 400'

No Lines 5@80' Trench Width 36" Max Trench Bottom Depth 36" Gravel Depth 12"

☒ New System ☐ Repair System Type: I, II, III, IV, V, VI

System Description: Gravity-Conventional

Repair System Description: Panel Block

Maintenance Agreement Required: ☐ Yes ☒ No

☒ House/Mod. Home ☐ Mobile Home ☐ Business ☐ Other

No. Bedrooms 3 No. Bathrooms 2.5 No. Employees


☒ Slab ☒ Crawl Space ☐ Basement w/plumbing ☐ Basement wo/plumbing

Water Supply: ☒ Individual ☐ Public ☐ Community


Comments/Conditions: Keep Septic System at least 10' from PL & at least 50' to well. Keep well 25' from house (Back of house can't be greater than 90' to Front PL)

Comments/Conditions: Polylok filter installed.

INITIAL SITE SKETCH Scale 1:50

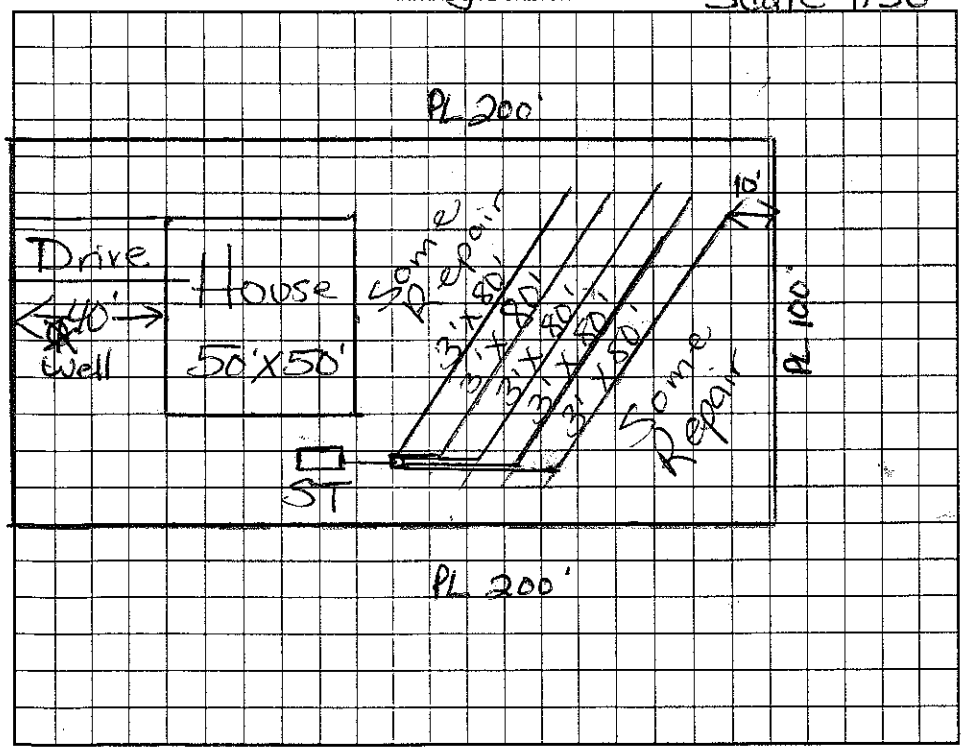

AS BUILT SKETCH

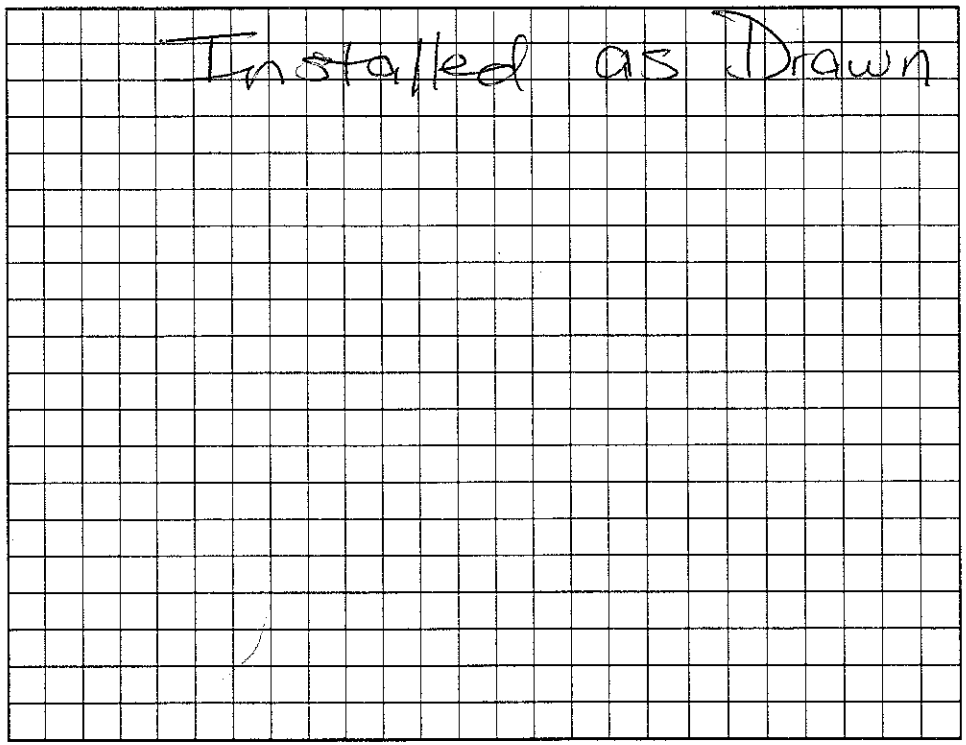

Permit can be suspended or revoked if any false information is supplied toward securing the permit/any unauthorized changes are made to the site/any unauthorized changes are made in the installation of the system. Improvement Permit with plat valid without expiration. Improvement Permit with site plan valid for sixty months. Authorization to Construct is valid for a period equal to that of Improvement Permit – not to exceed sixty months.

Signed: [signature] date 3-11-02 Installed by: Richard Abernathy LLC

Improvement Permit by: Maria H. Dolson RS date 3/6/2002 Operation Permit by: Maria H. Dolson RS date 6/6/2002

Authorization to Construct by: Maria H. Dolson RS date 3/6/2002 Existing System Inspection by: date

HEALTH DEPT. COPY: WHITE OWNER COPY (FINAL): YELLOW OWNER COPY (INITIAL): PINK