IREDELL COUNTY HEALTH DEPARTMENT

STATESVILLE 704-878-5305 | 130.00 Paid (3.00) MOORESVILLE 704-664-5281

IMPROVEMENT PERMIT / AUTHORIZATION TO CONSTRUCT / OPERATION PERMIT / EXISTING SYSTEM INSPECTION

PERMIT# 104827 PIN# 4648069799 DATE 3-6-2002

OWNER OR CONTRACTOR Shaun Ogden (Formerly Bill Mclain) PHONE: Business 309-6810 Home

ADDRESS P.O. Box 1280 Davidson NC 28036

LOCATION Hwy 21 N TL Cornelius Rd TR Blackbeard Ln

SUBDIVISION Pirates Cove BLOCK / SECTION LOT 5 LOT AREA 100'X200' SITE CLASS PS DESIGN FLOW 360gpd L.T.A.R. .3

Septic Tank: 1000 Gallons; STB 1012 Date 3-4-02
Pump Tank: Gallons; PT Date
Pump Make: Model Serial No.
Nitrification Field: No Fields 1 Square Feet 1200' Linear Feet 300'
No Lines 6@50'ea Trench Width 36" Max Trench Bottom Depth 36" Gravel Depth N/A

[X] New System [ ] Repair System Type: I, II, III, IV, V, VI
System Description: Gravity - 25% Reduction
Repair System Description: Pump - Panel
Maintenance Agreement Required: [ ] Yes [X] No


[X] House/Mod. Home No. Bedrooms 3
[ ] Mobile Home No. Bathrooms 2.5
[ ] Business No. Employees
[ ] Other
[X] Slab [X] Crawl Space [ ] Basement w/plumbing [ ] Basement wo/plumbing

Water Supply: [X] Individual [ ] Public [ ] Community

Comments:/Conditions: Keep Septic System at least 10' From PL and at least 50' from any well. Keep well 25' From house. (Back of house can't be greater than 90' to front PL)


INITIAL SITE SKETCH

Scale 1:50

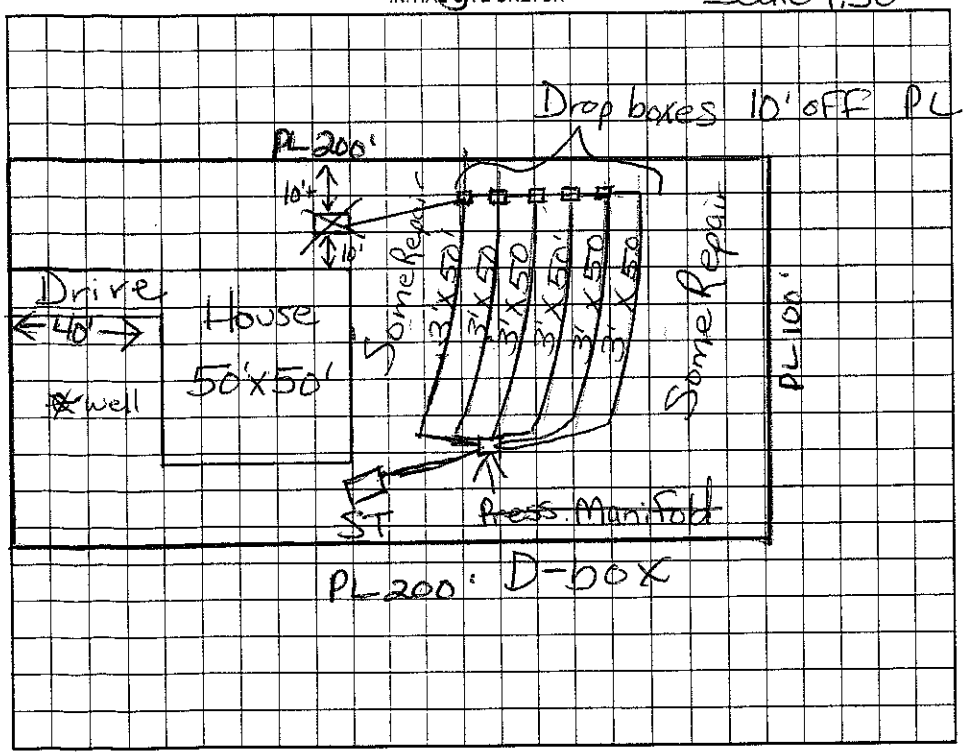

Comments:/Conditions: Note: Short lines due to irregular topo & thick vegetation. Poly lok Filter installed (Okay to use distribution box)

AS BUILT SKETCH

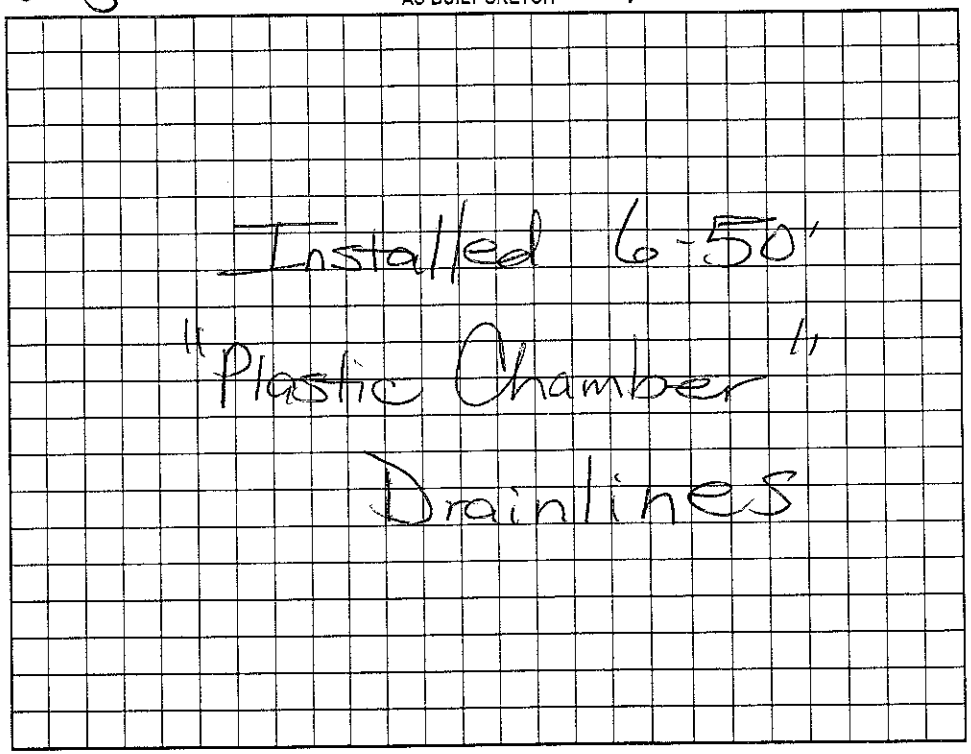

Permit can be suspended or revoked if any false information is supplied toward securing the permit/any unauthorized changes are made to the site/any unauthorized changes are made in the installation of the system. Improvement Permit with plat valid without expiration. Improvement Permit with site plan valid for sixty months. Authorization to Construct is valid for a period equal to that of Improvement Permit – not to exceed sixty months.

Signed: Shaun Ogden date 3-11-02 Installed by: Richard Abernathy

Improvement Permit by: Maina H. H. Dotson RS date 3/6/2002 Operation Permit by: Maina H. H. Dotson RS date 6/4/2002

Authorization to Construct by: Maina H. H. Dotson RS date 3/6/2002 Existing System Inspection by: date

HEALTH DEPT. COPY: WHITE OWNER COPY (FINAL): YELLOW OWNER COPY (INITIAL): PINK