IREDELL COUNTY HEALTH DEPARTMENT

STATESVILLE 704-878-5305 325.00 Paid MOORESVILLE 704-664-5281 4.00

IMPROVEMENT PERMIT / AUTHORIZATION TO CONSTRUCT / OPERATION PERMIT / EXISTING SYSTEM INSPECTION

PERMIT# 101905 PIN# 4648075182

OWNER OR CONTRACTOR Kimberly & Paul Volk PHONE: Business 662-8600 ext 62 Home 660-0608 DATE 11-30-01

ADDRESS 130 Overcreek Rd Mooresville NC 28117

LOCATION US 21 N TL Cornelius TL Morgan PS Landing on right

SUBDIVISION Pirates Cove BLOCK / SECTION ____ LOT 32 LOT AREA .5 acre SITE CLASS. PS DESIGN FLOW 360gpd L.T.A.R ____

Septic Tank: 1000 Gallons; STB 794 Date 11-8-03

Pump Tank: 1000 Gallons; PT 27 Date 1-3-04

Pump Make Little Giant Model ____ Serial No. ____

Nitrification Field: No Fields 1 Square Feet 400 Linear Feet 200'

No Lines 4 Trench Width 24" Max Trench Bottom Depth 30" Gravel Depth N/A

[X] New System [ ] Repair System Type: I, II, III, IV, V, VI

System Description: Pump (LP) Panel Block

Repair System Description: Deeded prior to 1983

Maintenance Agreement Required: [X] Yes [ ] No

[X] House/Mod. Home [ ] Mobile Home [ ] Business [ ] Other

No. Bedrooms 3 No. Bathrooms 2.5 No. Employees ____


[ ] Slab [ ] Crawl Space [X] Basement w/plumbing [ ] Basement wo/plumbing

Water Supply: [X] Individual [ ] Public [ ] Community

Comments/Conditions: Keep drainlines at least 10' from PL, 50' from lake & 50' from any well. Basement wall must be at least 35' from drainfield

Comments/Conditions: Must get well variance from DHNER for well closer than 50' to lake. Very tight lot, be careful of setbacks. 3/16" hole drilled Reviewed plans 7/30/03

INITIAL SITE SKETCH Scale 1:50

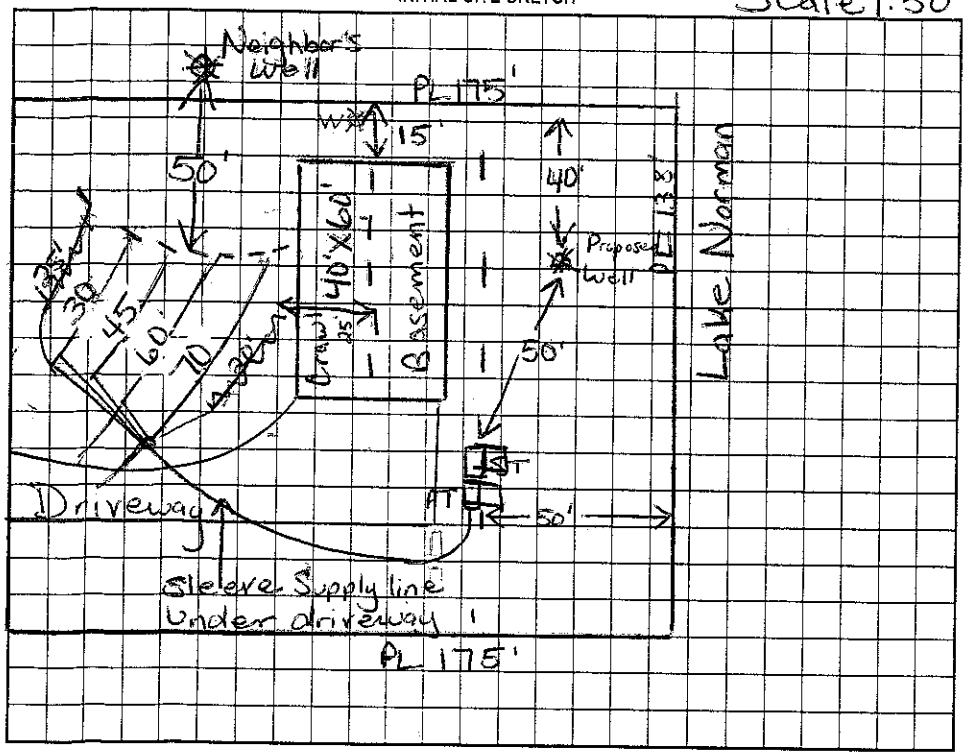

AS-BUILT SKETCH

Okay to put drive on other side of house as long as drainfield stays in the same place.

Revised well site w 7' from PL 50' from neighbor's drainfield

Permit can be suspended or revoked if any false information is supplied toward securing the permit/any unauthorized changes are made to the site/any unauthorized changes are made in the installation of the system. Improvement Permit with plat valid without expiration. Improvement Permit with site plan valid for sixty months. Authorization to Construct is valid for a period equal to that of Improvement Permit – not to exceed sixty months.

Signed: Kimberly A Volk date 12-17-01

Improvement Permit by: Maina H H Dotson RS date 12-1-01

Authorization to Construct by: Maina H H Dotson RS date 7/30/03

Installed by: Richard Abernathy RS

Operation Permit by: Maina H H Dotson date 3/10/04

Existing System Inspection by: ____ date ____

HEALTH DEPT. COPY: WHITE OWNER COPY (FINAL): YELLOW OWNER COPY (INITIAL): PINK