IREDELL COUNTY HEALTH DEPARTMENT

STATESVILLE 704-878-5305 MOORESVILLE 704-664-5281

IMPROVEMENT PERMIT / CERTIFICATE OF COMPLETION / OPERATION PERMIT / EXISTING SYSTEM INSPECTION

PROPERTY DESCRIPTION NO. 22175 DATE 2/28/97 TAX MAP NO. pt of 2SA51 Watershed: ☐ Yes ☐ No

OWNER OR CONTRACTOR VAROM FINANCIAL SERVICES PHONE: Business _____ Home _____

ADDRESS 149 YACHT COVE RR MOORESVILLE NC 28115 4648-08-0182

LOCATION CORNELIUS RD - TURN CREEK VIEW AT END

SUBDIVISION MILLS POND BLOCK / SECTION _____ LOT 46 LOT AREA 1.41 AC SITE CLASS. PS DESIGN FLOW 360GPD L.T.A.R. .3 gpd/sq ft

Septic Tank: 1000 Gallons; STB 825 Date 12/18/96

Pump Tank: _____ Gallons; PT _____ Date _____

Pump Make: _____ Model _____ Serial No. _____

Nitrification Field: No Fields 10 Square Feet 900 Linear Feet 300

No Lines 6@50' Trench Width 36" Max Trench Bottom Depth 36" Gravel Depth SAND

☑ New System ☐ Repair System Type: I, II, III, IV, V, VI

System Description: GRAVITY CHAMBERED

Repair System Description: PUMP CHAMBERED

Maintenance Agreement Required: ☐ Yes ☑ No

☑ House/Mod. Home No. Bedrooms 3

☐ Mobile Home No. Bathrooms 2

☐ Business No. Employees ____

☐ Other _____


☐ Slab ☑ Crawl Space ☐ Basement w/plumbing ☐ Basement wo/plumbing

Water Supply:
☑ Individual
☐ Community
☐ Public


Comments:

Comments:

INITIAL SITE SKETCH

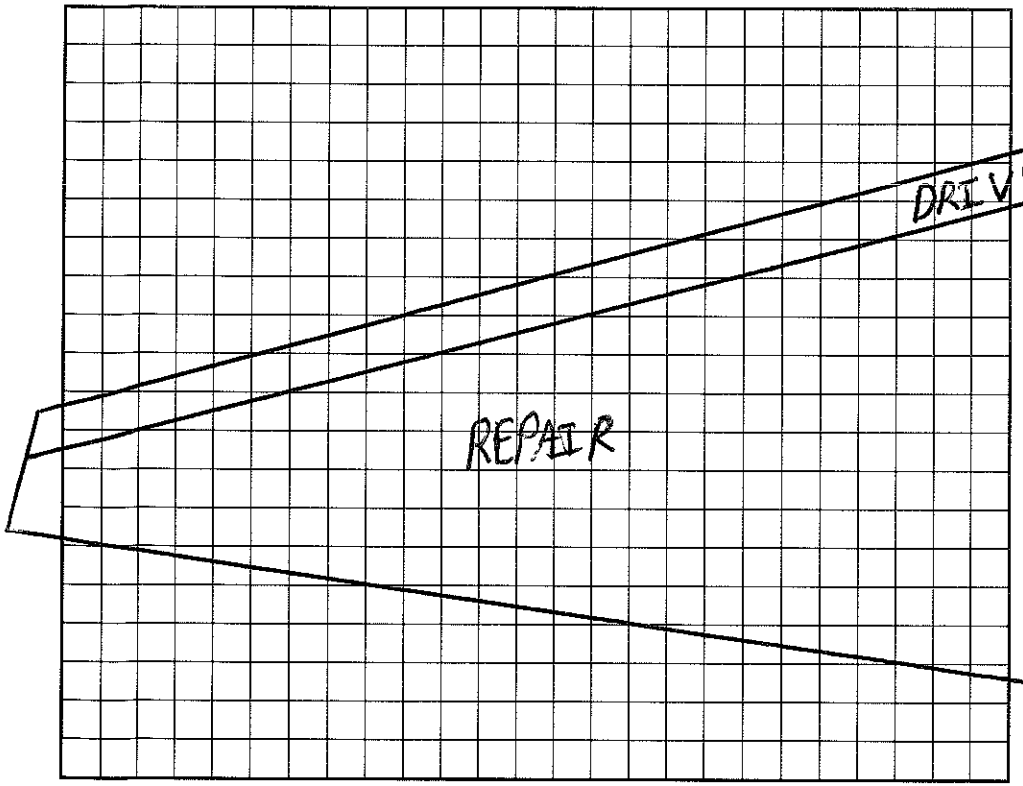

AS BUILT SKETCH

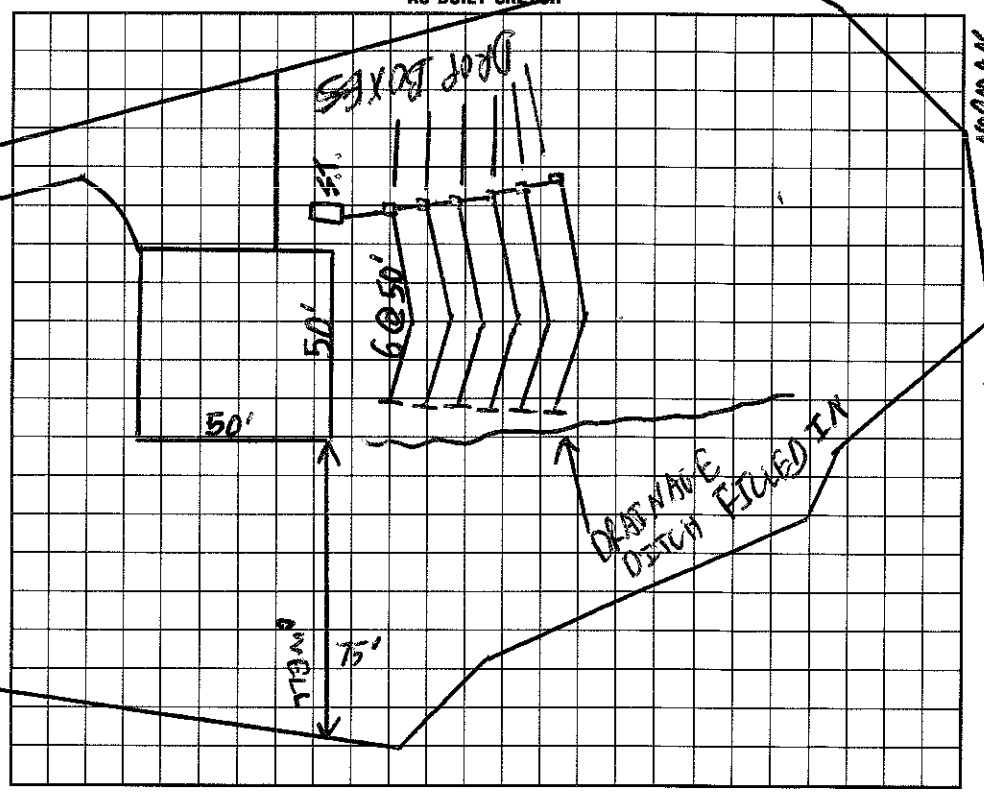

I understand that this permit can be suspended or revoked if any false information is supplied toward securing the permit/any unauthorized changes are made to the site/any unauthorized changes are made in the installation of the system. Improvement Permit is valid for 60 months from date of issuance.

Signed: _____

Improvement Permit by: BY / DAVID HENSON date 2-9-96

Existing System Inspection by: BY / DAVID HENSON date 2-9-96

Installed by: ROWAN SEPTIC

Certificate of Completion by: _____ date _____

Operation Permit by: _____ date 2/19/97

HEALTH DEPT. COPY: WHITE / INSPECTION COPY (FINAL): GREEN / OWNER COPY (FINAL): YELLOW / INSPECTION COPY (INITIAL): PINK / OWNER COPY (INITIAL): GOLD