IREDELL COUNTY HEALTH DEPARTMENT

STATESVILLE 704-878-5305 MOORESVILLE 704-664-5281

IMPROVEMENT PERMIT / CERTIFICATE OF COMPLETION / OPERATION PERMIT / EXISTING SYSTEM INSPECTION

PROPERTY DESCRIPTION NO. 22180 DATE Dec 20, '95 TAX MAP NO. part of 2SA51 Watershed: ☑ Yes ☐ No

OWNER OR CONTRACTOR Krom Financial Services PHONE: Business Home WS4CA

ADDRESS 199 Yacht Cove Rd., Mooresville 4648-08-0509

LOCATION Conelius Rd. Turn on Creekview Ln. on left at end 0.5mi

SUBDIVISION Mills Pond BLOCK / SECTION LOT 51 LOT AREA 20,000ft² SITE CLASS. PS DESIGN FLOW 360gpd L.T.A.R. .3

Septic Tank: 1000 Gallons; STB 825 Date 11/4/96

Pump Tank: Gallons; PT Date

Pump Make: Model Serial No.

Nitrification Field: No Fields 1 Square Feet 1200 Linear Feet 400

No Lines 5@100 Trench Width 36" Max Trench Bottom Depth Gravel Depth

☑ New System ☐ Repair System Type: I, ☑ II, III, IV, V, VI

System Description: gravity conventional

Repair System Description: grav/pumped INF.

Maintenance Agreement Required: ☐ Yes ☑ No

☑ House/Mod. Home No. Bedrooms 3

☐ Mobile Home No. Bathrooms 2

☐ Business No. Employees

☐ Other

☐ Slab ☑ Crawl Space ☐ Basement w/plumbing ☐ Basement wo/plumbing


Water Supply: ☑ Individual ☐ Community ☐ Public

Comments: Exit plumbing at or slightly above existing grade at left rear of house in order to avoid use of a pump.

Comments:

INITIAL SITE SKETCH

1"=50'

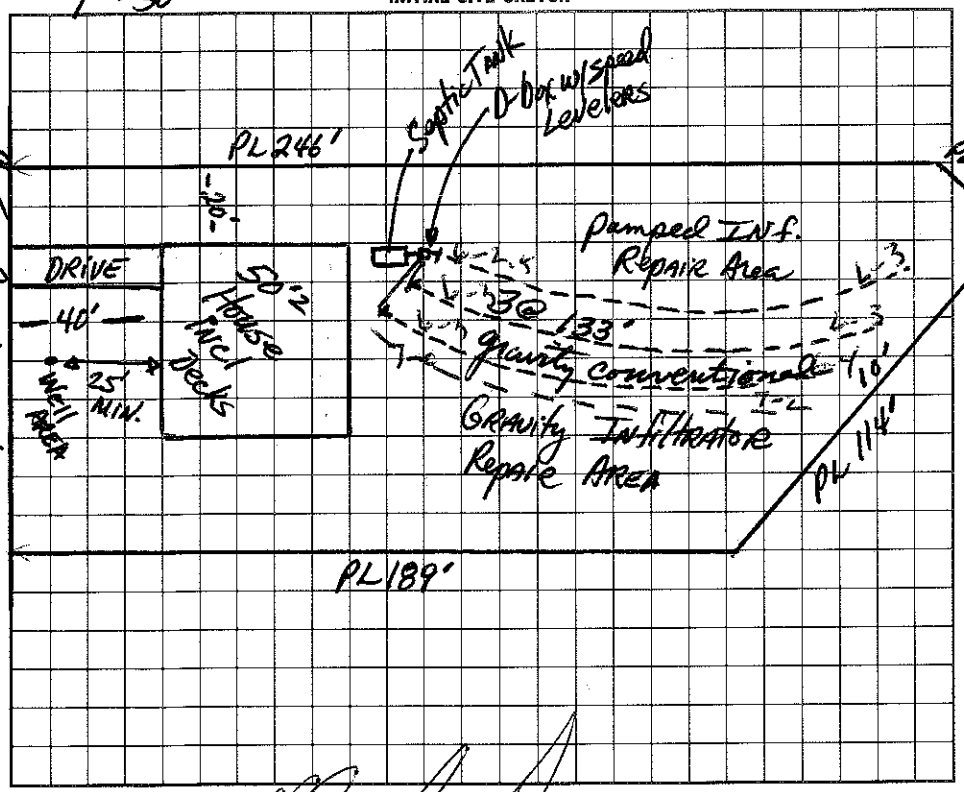

AS BUILT SKETCH

I understand that this permit can be suspended or revoked if any false information is supplied toward securing the permit/any unauthorized changes are made to the site/any unauthorized changes are made in the installation of the system.

Signed:

Installed by: Rowan Septic Tank

Improvement Permit by: J R Hinson RS. date 12-20-95

Certificate of Completion by: date

Existing System Inspection by: J R Hinson RS date Jan 11, '96

Operation Permit by: Wendy Sparks RS date 12/11/96

Authorization to construct

HEALTH DEPT. COPY: WHITE INSPECTION COPY (FINAL): GREEN OWNER COPY (FINAL): YELLOW INSPECTION COPY (INITIAL): PINK OWNER COPY (INITIAL): GOLD