(3.30)

IREDELL COUNTY HEALTH DEPARTMENT

STATESVILLE 704-878-5305 MOORESVILLE 704-664-5281

IMPROVEMENT PERMIT / CERTIFICATE OF COMPLETION / OPERATION PERMIT / EXISTING SYSTEM INSPECTION

PROPERTY DESCRIPTION NO. 22177 - DATE Dec 5, '95 TAX MAP NO. part of 2SA51 Watershed: ☑ Yes ☐ No WS4CA

OWNER OR CONTRACTOR Krom Financial Services PHONE: Business Home 4648-08-1490

ADDRESS 149 Quiet Cove Ln. Mooresville

LOCATION Cornelius Rd Turn on Creekview to end

SUBDIVISION Mills Pond BLOCK / SECTION LOT 48 LOT AREA 1.05Ac SITE CLASS. 5 DESIGN FLOW 360gpd L.T.A.R. .03

Septic Tank: 1000 Gallons; STB 825 Date 2/5/97

Pump Tank: Gallons; PT Date

Pump Make: Model Serial No.

Nitrification Field: No Fields 1 Square Feet 1200 Linear Feet 400

No Lines 5@80 Trench Width 36" Max Trench Bottom Depth 36" Gravel Depth 12"

☑ New System ☐ Repair System Type: I, II, III, IV, V, VI

System Description: gravity conventional

Repair System Description: pumped CONV / IAF

Maintenance Agreement Required: ☐ Yes ☑ No

☑ House/Mod. Home No. Bedrooms 3

☐ Mobile Home No. Bathrooms 2

☐ Business No. Employees

☐ Other


☐ Slab ☑ Crawl Space ☐ Basement w/plumbing ☐ Basement wo/plumbing

Water Supply: ☑ Individual ☐ Community ☐ Public

Comments: Exit plumbing AT or slightly above existing grade to AVOID pumping entirely. WELL must go exactly where shown. 1"=100'

Comments: Well Not installed at time of final INSPECTION (OP)

INITIAL SITE SKETCH

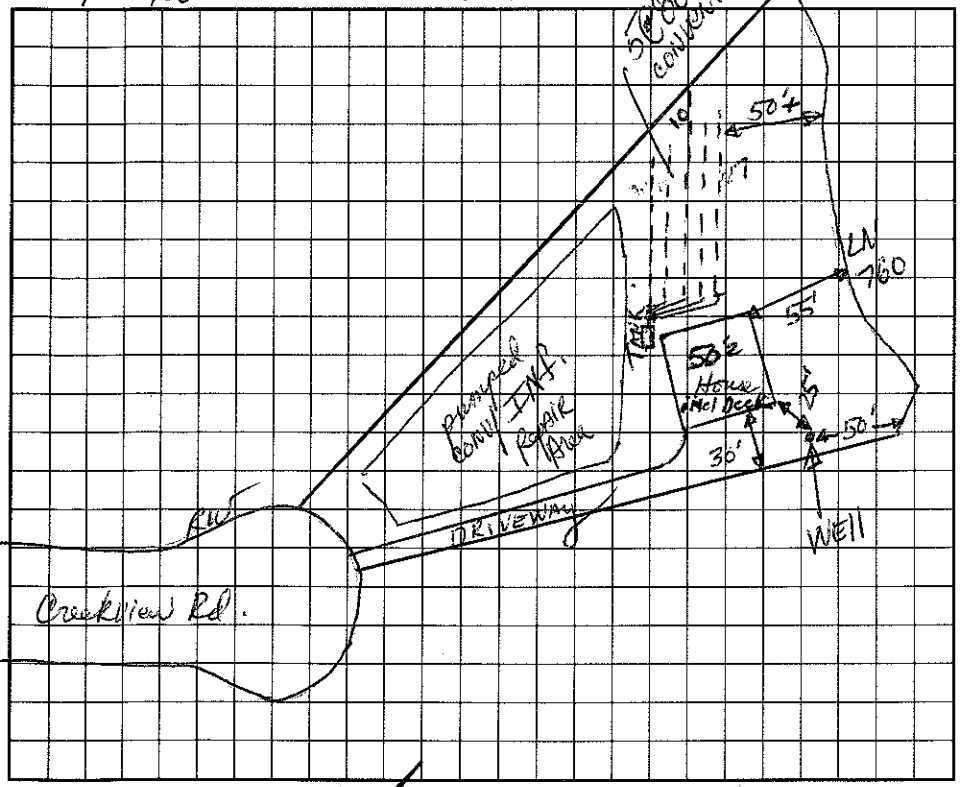

AS BUILT SKETCH

I understand that this permit can be suspended or revoked if any false information is supplied toward securing the permit/any unauthorized changes are made to the site/any unauthorized changes are made in the installation of the system.

Signed:

Improvement Permit by: D.K. Lyman, RS date 12-5-95

Existing System Inspection by: D.K. Lyman, RS date 12-29-95

Addition to ~~Existing System~~ Inspection by: to continue

Installed by: Rowan Septic

Certificate of Completion by: Maria H.H. Dotson date 8/18/97

Operation Permit by: Maria H.H. Dotson date 8/18/97

HEALTH DEPT. COPY: WHITE INSPECTION COPY (FINAL): GREEN OWNER COPY (FINAL): YELLOW INSPECTION COPY (INITIAL): PINK OWNER COPY (INITIAL): GOLD