IREDELL COUNTY HEALTH DEPARTMENT

STATESVILLE 704-878-5305 MOORESVILLE 704-664-5281

IMPROVEMENT PERMIT / CERTIFICATE OF COMPLETION / OPERATION PERMIT / EXISTING SYSTEM INSPECTION

PROPERTY DESCRIPTION NO. 22178 DATE Dec 20, '95 TAX MAP NO. part of 25A51 Watershed: ☑ Yes ☐ No WS4CA

OWNER OR CONTRACTOR Krom Financial Services PHONE: Business ______ Home ______ 4648-08-1595

ADDRESS 149 Yacht Cove Rd Mooresville

LOCATION Cornelius Rd. turn on Creekview to end on left

SUBDIVISION Mills Pond BLOCK / SECTION ______ LOT 49 LOT AREA .99 Ac SITE CLASS PS DESIGN FLOW 360 gpd L.T.A.R. ~.35

Septic Tank: 1000 Gallons; STB 825 Date 10/2/96
Pump Tank: ______ Gallons; PT ______ Date ______
Pump Make: ______ Model ______ Serial No. ______
Nitrification Field: No Fields 1 Square Feet 1035 Linear Feet 345
No Lines 3@115' Trench Width 36" Max Trench Bottom Depth 36" Gravel Depth 12"

☑ New System ☐ Repair System Type: I (II) III IV V VI
System Description: gravity conventional
Repair System Description: Same
Maintenance Agreement Required: ☐ Yes ☑ No

☑ House/Mod. Home ☐ Mobile Home ☐ Business ☐ Other ______
No. Bedrooms 3 No. Bathrooms 2 No. Employees ______


Water Supply: ☑ Individual ☐ Community ☐ Public

☐ Slab ☑ Crawl Space ☐ Basement w/plumbing ☐ Basement wo/plumbing

Comments: Complex Topo

Comments:

INITIAL SITE SKETCH 1" ~ 50'

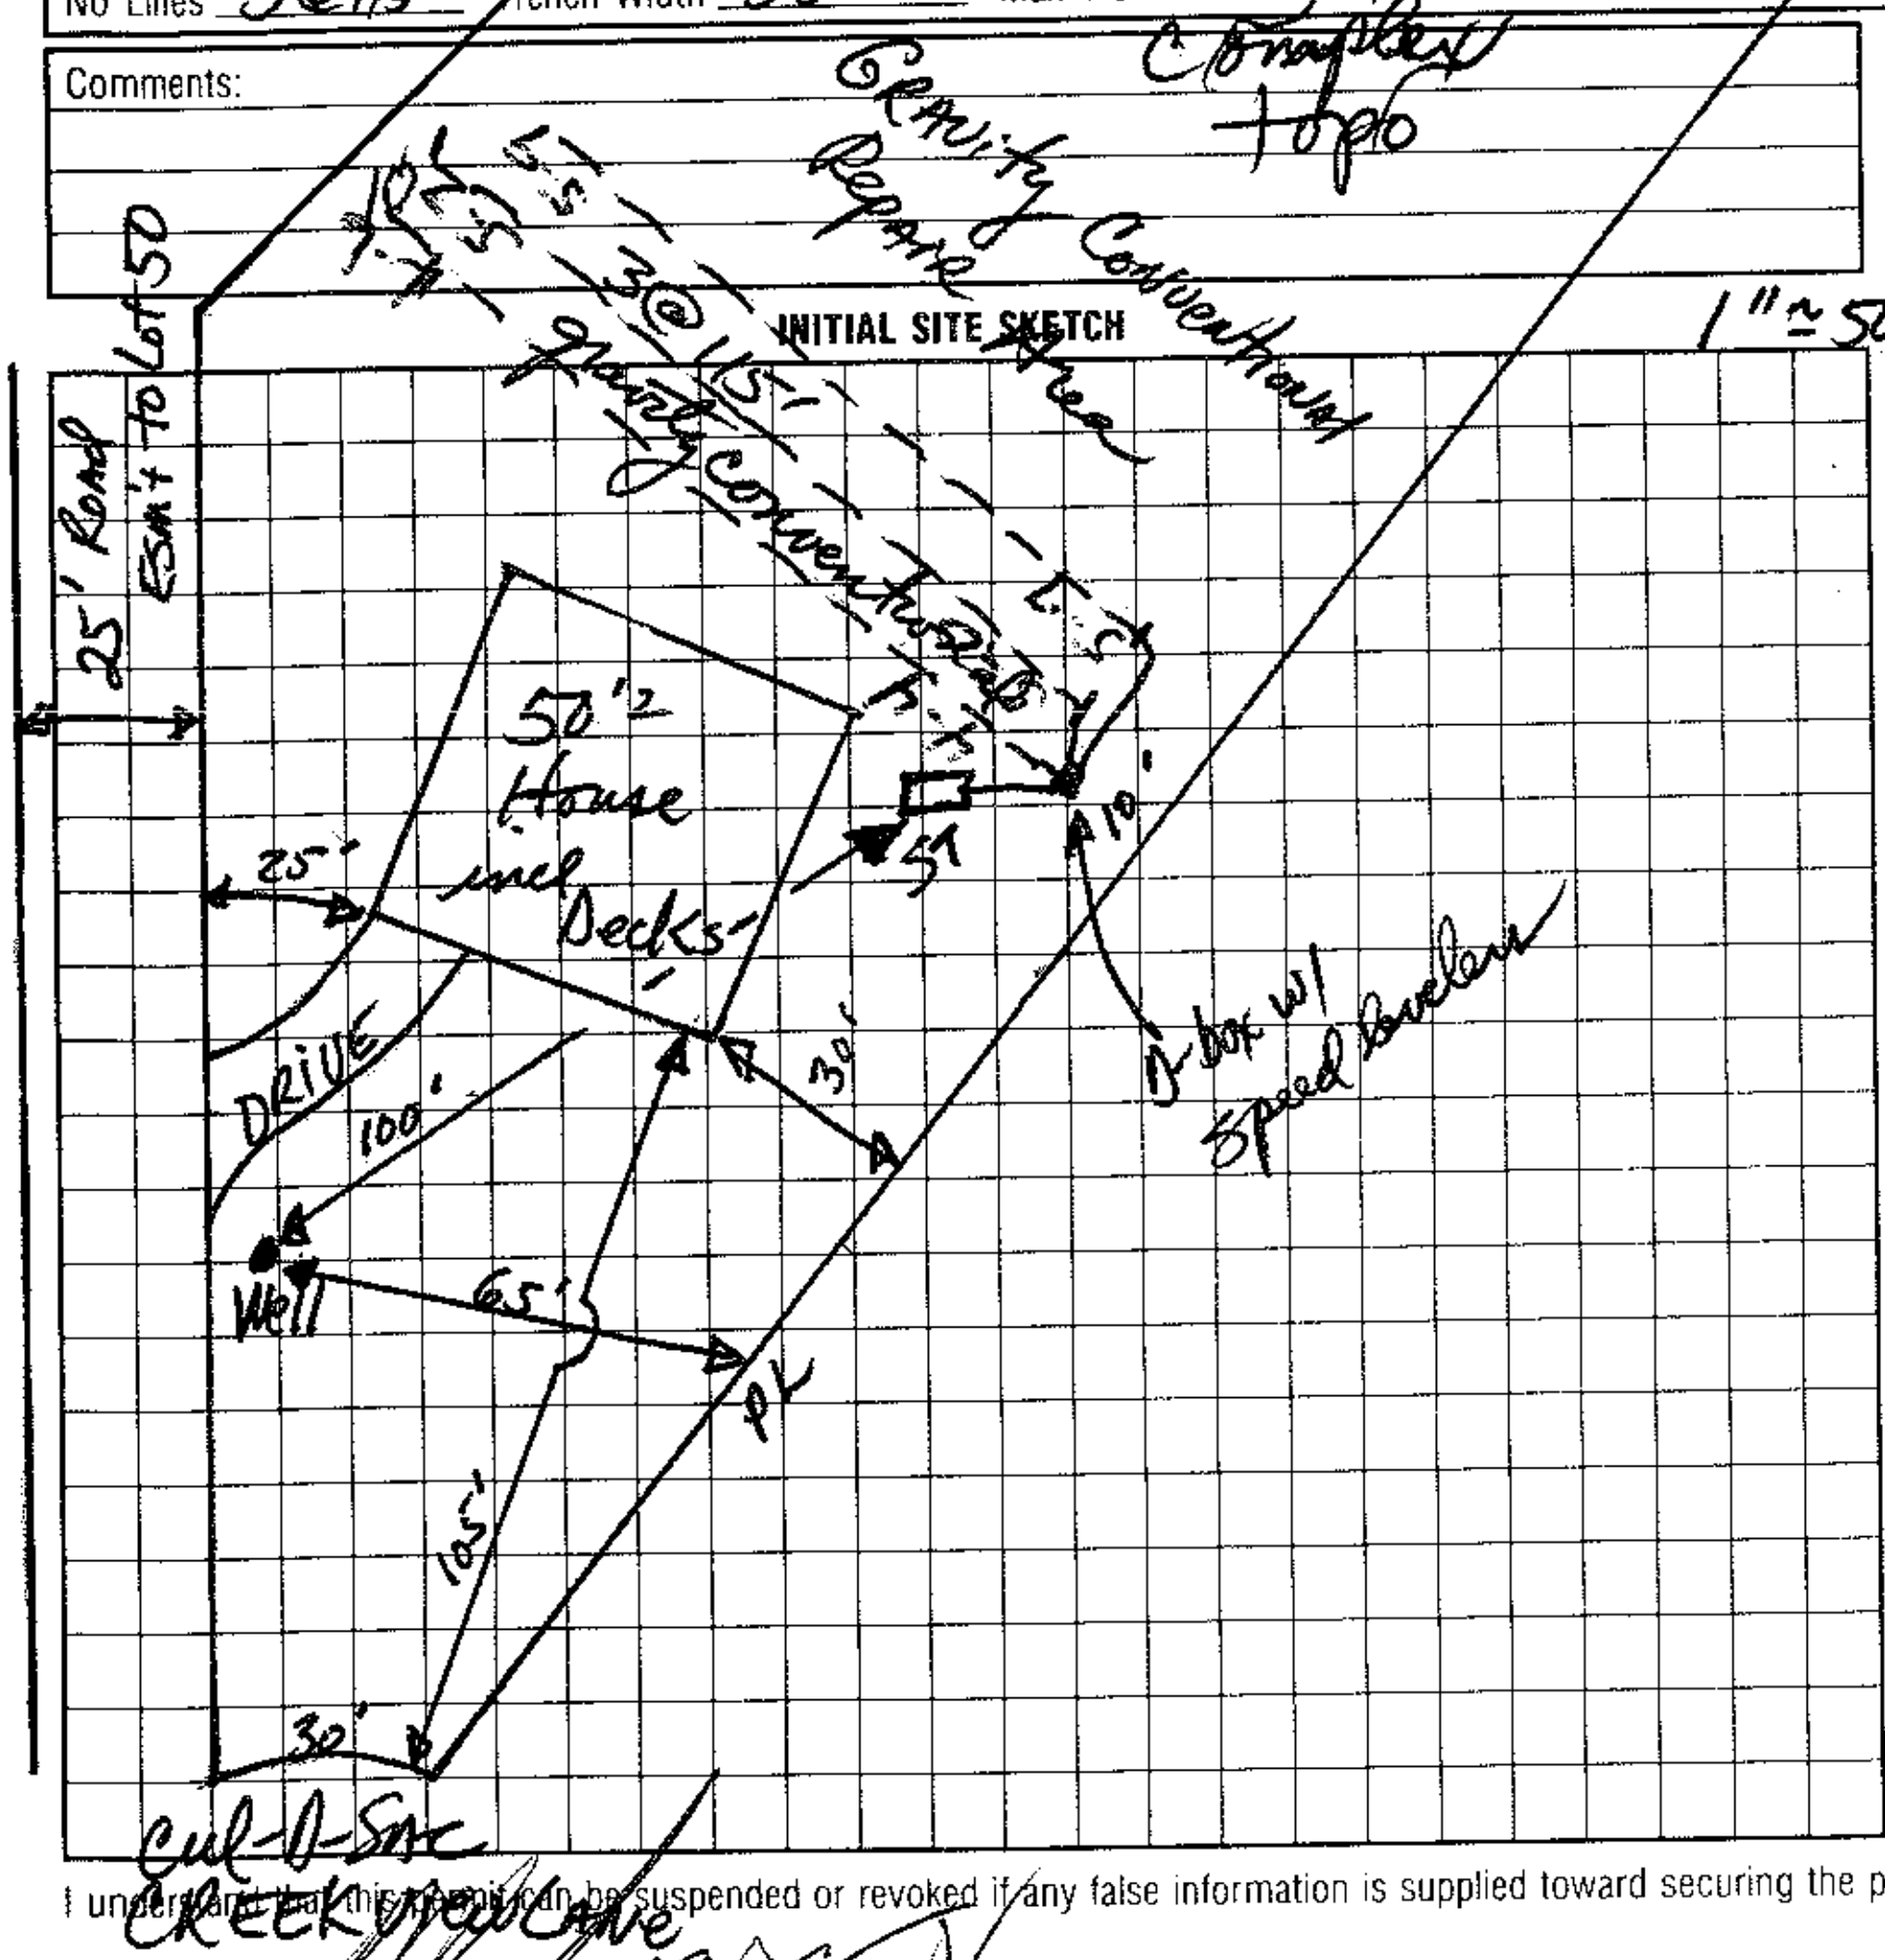

AS BUILT SKETCH

I understand that this permit can be suspended or revoked if any false information is supplied toward securing the permit/any unauthorized changes are made to the site/any unauthorized changes are made in the installation of the system.

Signed: ______

Improvement Permit by: Dean L. Hansen, RS date Dec 20, '95

Authorization to construct

Existing System Inspection by: DR Hansen, RS date Jan 11, '96

Installed by: Rowan Septic Tank

Certificate of Completion by: ______ date ______

Operation Permit by: Wesley Sparks R.S. date 12/18/96

HEALTH DEPT. COPY: WHITE INSPECTION COPY (FINAL): GREEN OWNER COPY (FINAL): YELLOW INSPECTION COPY (INITIAL): PINK OWNER COPY (INITIAL): GOLD