IREDELL COUNTY HEALTH DEPARTMENT

STATESVILLE 704-878-5305 MOORESVILLE 704-664-5281

IMPROVEMENT PERMIT / CERTIFICATE OF COMPLETION / OPERATION PERMIT / EXISTING SYSTEM INSPECTION

PROPERTY DESCRIPTION NO. 22179 . DATE Dec 20, '95 TAX MAP NO. part of 2545 1 4648 08 1697 Watershed: ☑ Yes ☐ No

OWNER OR CONTRACTOR Krom Financial Services PHONE: Business Home WS4CA

ADDRESS 149 Yacht Cove Rd., Mooresville

LOCATION Conselyea Rd. Turn on Creekview to END Th in cul-d-sac 221 Creek View Rd

SUBDIVISION Mills Pond BLOCK / SECTION 2 LOT 50 LOT AREA .72 Ac SITE CLASS. B pm. 1956 DESIGN FLOW 360 gpd L.T.A.R. .3

Septic Tank: 1000 Gallons; STB 425 Date 5/27/96

Pump Tank: 1000 Gallons; PT 47 Date 5/11/96

Pump Make: ZOELLER Model N 137 Serial No.

Nitrification Field: No Fields 1 Square Feet 900 Linear Feet 300

No Lines 4@75' Trench Width 36" Max Trench Bottom Depth 36" Gravel Depth NA

☑ New System ☐ Repair System Type: I, II, (III) IV, V, VI

System Description: pumped-pm-Infiltrator

Repair System Description: LP PPBRS

Maintenance Agreement Required: ☐ Yes ☑ No initially

☑ House/Mod. Home No. Bedrooms 3

☐ Mobile Home No. Bathrooms 2

☐ Business No. Employees

☐ Other

☐ Slab ☑ Crawl Space ☐ Basement w/plumbing ☐ Basement wo/plumbing


Water Supply: ☑ Individual ☐ Community ☐ Public

Comments: Very limited space, combined w/ complex topo. Everything must be located as shown. Recommend smaller house footprint than shown.

Comments: installed as drawn -

1" = 50'

INITIAL SITE SKETCH

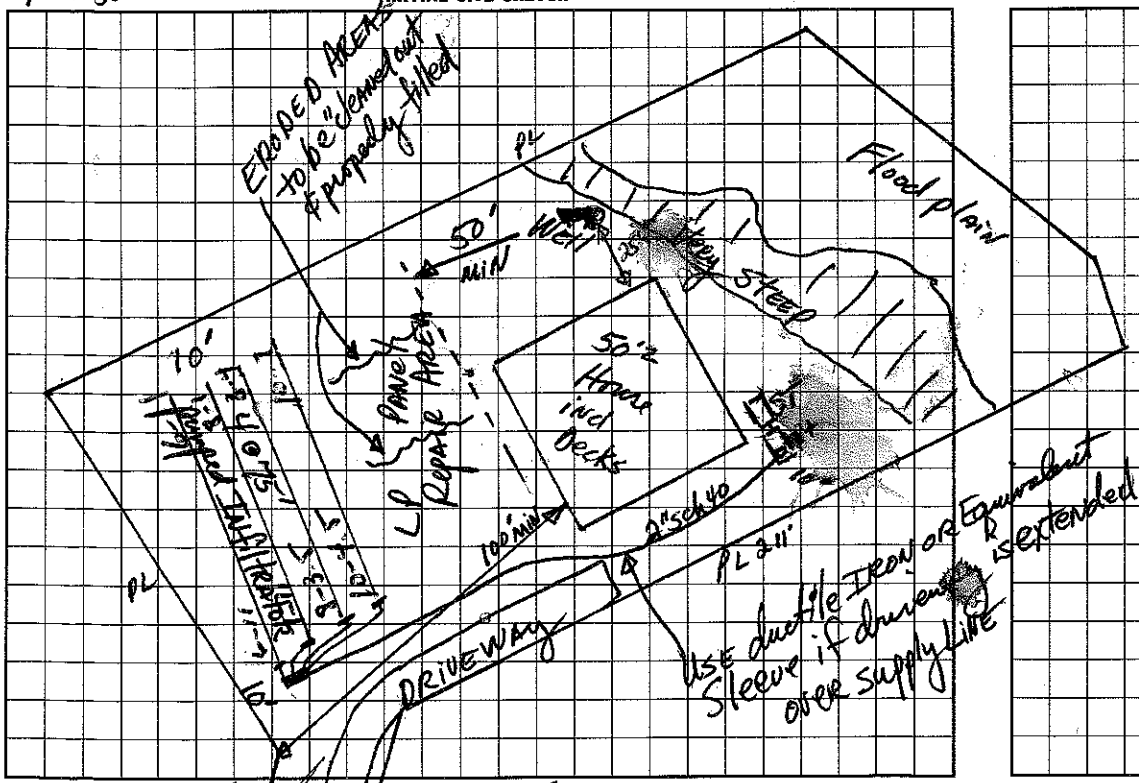

AS BUILT SKETCH

I understand that this permit can be suspended or revoked if any false information is supplied toward securing the permit/any unauthorized changes are made to the site/any unauthorized changes are made in the installation of the system.

Signed:

Improvement Permit by: Darrell R Hinson, RS date Dec 20, '95

Authorization to Inspection by: DR Hinson, RS date Jan 11, '96

Installed by: Rowan Septic Tank

Certificate of Completion by: date

Operation Permit by: Wesley Sparks RS date 7/12/96

DEPT. COPY: WHITE INSPECTION COPY (FINAL): GREEN OWNER COPY (FINAL): YELLOW INSPECTION COPY (INITIAL): PINK OWNER COPY (INITIAL): GOLD