IREDELL COUNTY HEALTH DEPARTMENT

STATESVILLE 704-878-5305 MOORESVILLE 704-664-5281

IMPROVEMENT PERMIT / CERTIFICATE OF COMPLETION / OPERATION PERMIT / EXISTING SYSTEM INSPECTION

Watershed: ☐ Yes ☐ No

PROPERTY DESCRIPTION NO. ~~17279~~ 17287 DATE 3-10-94 TAX MAP NO. 25 A 51

OWNER OR CONTRACTOR KROM FINANCIAL SERVICES PHONE: Business 664-3671 Home

ADDRESS 19 Yacht Cove Mooresville NC 28115 4648-08-6883

LOCATION ~~XXXXXXXXXXXX~~ north side of cornelius road west of judas road

SUBDIVISION MILLS FOREST BLOCK / SECTION II LOT 41 LOT AREA 20,000min SITE CLASS. P DESIGN FLOW 360 L.T.A.R. 0.25

Septic Tank: 1000 Gallons; STB 825 Date 7/11/94

Pump Tank: _____ Gallons; PT _____ Date _____

Pump Make: _____ Model _____ Serial No. _____

Nitrification Field: No Fields 1 Square Feet 1440 Linear Feet 480

No Lines 8 Trench Width 36" Max Trench Bottom Depth 24"

☒ New System ☐ Repair System Type: I, (II), III, IV, V, VI

System Description: gravity conventional

Repair System Description: LPP

Maintenance Agreement Required: ☐ Yes ☒ No

Gravel Depth 12" ☐ Slab ☒ Crawl Space ☐ Basement w/plumbing ☐ Basement wo/plumbing

☒ House/Mod. Home No. Bedrooms 3

☐ Mobile Home No. Bathrooms 2

☐ Business No. Employees ____


☐ Other _____

Water Supply: ☒ Individual ☐ Community ☐ Public

Comments: do not install during wet soil conditions or rain.
direct downspouts away from system

Comments: Installed essentially as shown on I.P.

INITIAL SITE SKETCH

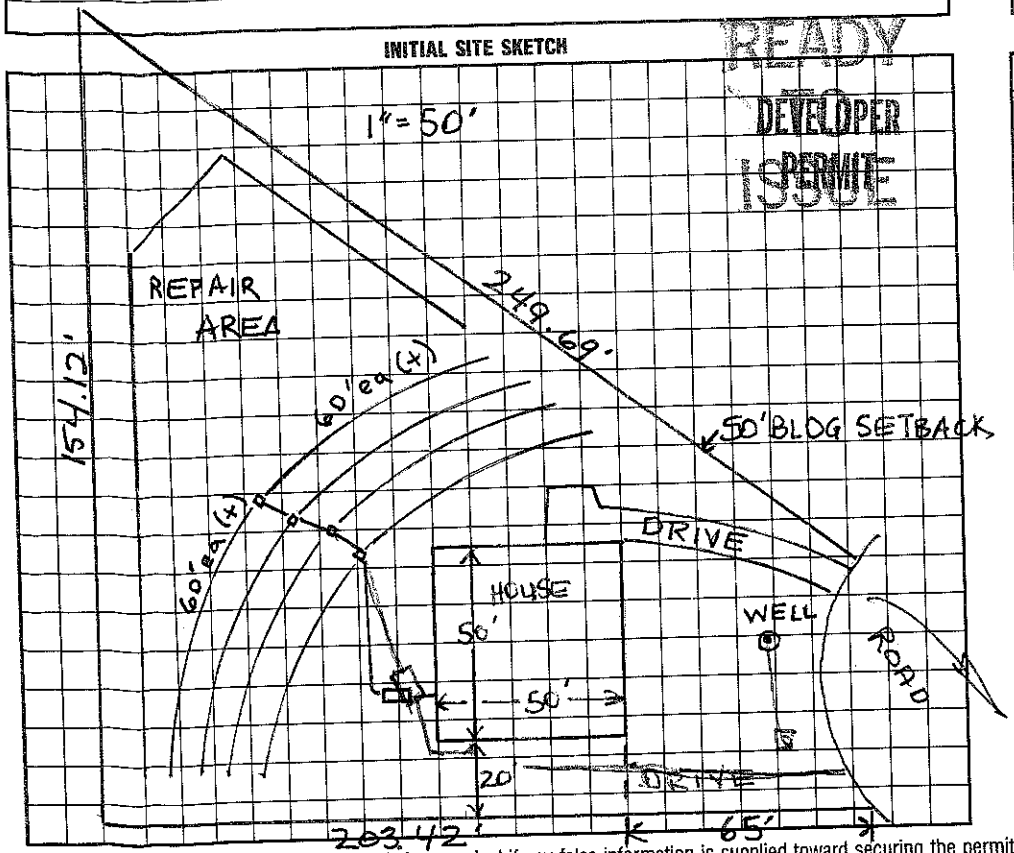

AS BUILT SKETCH

I understand that this permit can be suspended or revoked if any false information is supplied toward securing the permit/any unauthorized changes are made to the site/any unauthorized changes are made in the installation of the system. Improvement Permit is valid for 60 months from date of issuance.

Signed: _____ Exis.

Permit by: Andrea Lemon date 3-14-94

by: _____ date _____

Installed by: Rawan Septic Tank

Certificate of Completion by: Wesley Sparks R.S date 12/1/94

Operation Permit by: _____ date _____

COPY: WHITE INSPECTION COPY (FINAL): GREEN OWNER COPY (FINAL): YELLOW INSPECTION COPY (INITIAL): PINK OWNER COPY (INITIAL): GOLD

