IREDELL COUNTY HEALTH DEPARTMENT

STATESVILLE 704-878-5305 MOORESVILLE 704-664-5281

IMPROVEMENT PERMIT / CERTIFICATE OF COMPLETION / OPERATION PERMIT / EXISTING SYSTEM INSPECTION

PROPERTY DESCRIPTION NO. 6152 DATE 7/27/93 TAX MAP NO. 25 A 13

OWNER OR CONTRACTOR SPEAR CONST. CO PHONE: Business 636-7954 Home 4648-08-8674

ADDRESS

LOCATION CORNELIUS RD ~ .4 mile west of JOHNS RD

SUBDIVISION MILLS FOREST BLOCK / SECTION — LOT 13 LOT AREA .56 Ac SITE CLASS. P L.T.A.R. : 3

Water Supply: ☑ Individual ☐ Community ☐ Public UNDERCONST.

Septic Tank: 1000 Gallons; STB 825 Date 6-14-93

Pump Tank: Gallons; PT Date

Nitrification Field: No Fields 1 Square Feet 1200 Aus Linear Feet 400

No Lines 6 Trench Width 36" Trench Depth 24" Gravel Depth 12"

☑ New System ☐ Repair System Type: I (II) II, IV, V, VI

System Description: GRAV - CONV.

Repair System Description: GRAV - CONV.

Maintenance Agreement Required: ☐ Yes ☐ No

☑ House/Mod. Home No. Bedrooms 3 Garbage Disposal: ☐ Yes ☑ No

☐ Mobile Home No. Bathrooms 2 Auto. Dishwasher: ☑ Yes ☐ No

☐ Business No. Employees Auto. Washing Machine: ☑ Yes ☐ No

☐ Other Other


☐ Slab ☑ Crawl Space ☐ Basement w/plumbing ☐ Basement wo/plumbing

Comments

INITIAL SITE SKETCH

8-20-93 WELL COMPLETED ABOUT 3 WEEKS AGO, MOVED TO DIFFERENT LOCATION DUE TO POOR DRILLING CONDITIONS. NEW SITE ~20' FROM SIDE PR. & ~15' FROM FRONT PR. A. LEMON

AS BUILT SKETCH

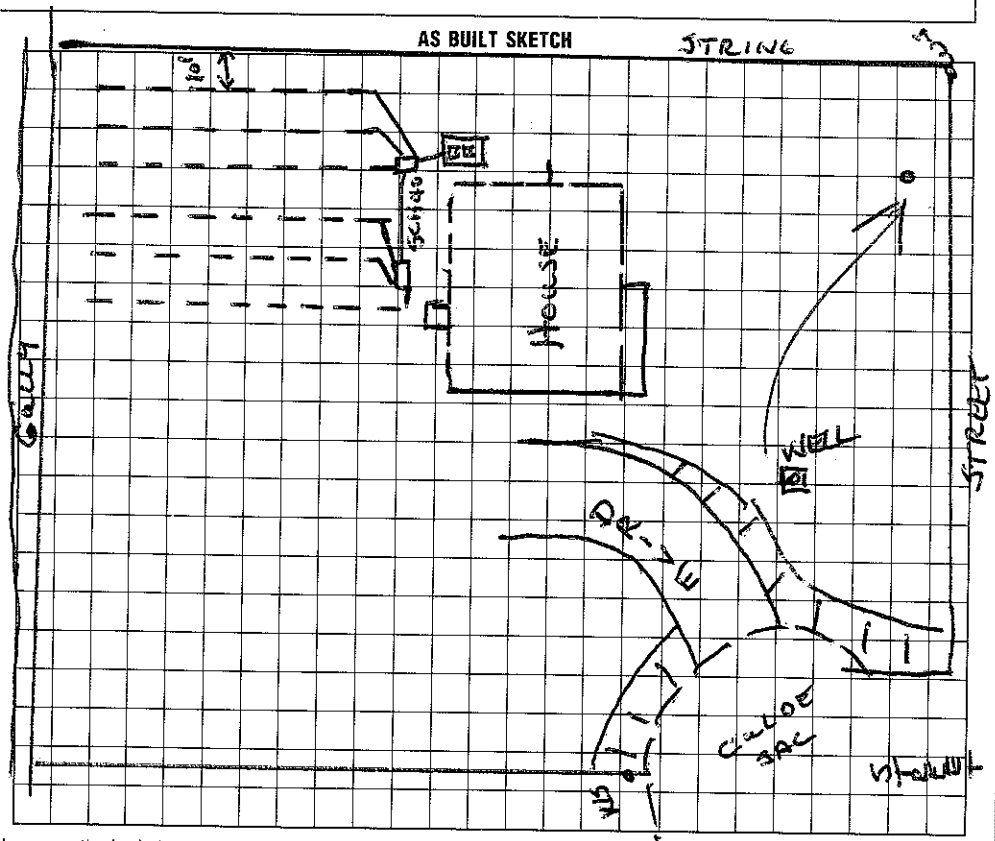

I understand that this permit can be suspended or revoked if any false information is supplied toward securing the permit/any unauthorized changes are made to the site/any unauthorized changes are made in the installation of the system. Improvement Permit is valid for 60 months from date of issuance.

Signed:

Improvement Permit by: date

Existing System Inspection by: date

Installed by: ROWAN SEPTIC TANK

Certificate of Completion by: Wesley Sparks RS. date 7/27/93

Operation Permit by: date

HEALTH DEPT. COPY: WHITE INSPECTION COPY (FINAL): GREEN OWNER COPY (FINAL): YELLOW INSPECTION COPY (INITIAL): PINK OWNER COPY (INITIAL): GOLD