IREDELL COUNTY HEALTH DEPARTMENT

STATESVILLE 704-878-5305 MOORESVILLE 704-664-5281

IMPROVEMENT PERMIT / CERTIFICATE OF COMPLETION / OPERATION PERMIT / EXISTING SYSTEM INSPECTION

PROPERTY DESCRIPTION NO. ~~17280~~ 17271 DATE 3-10-94 TAX MAP NO. 25 A 51 Watershed: ☐ Yes ☐ No

OWNER OR CONTRACTOR KROM FINANCIAL SERVICES PHONE: Business ~~XXXXXX~~ Home

ADDRESS 19 Yacht Cove Mooresville NC 28115 664-3671 4648-08-8806

LOCATION north side of cornelius road west of judas road

SUBDIVISION MILLS FOREST BLOCK / SECTION II LOT 42 LOT AREA 20,000min SITE CLASS. P DESIGN FLOW 360 L.T.A.R. 0.25

Septic Tank: 1000 Gallons; STB 825 Date 12/8/94

Pump Tank: ____ Gallons; PT ____ Date ____

Pump Make: ____ Model ____ Serial No. ____

Nitrification Field: No Fields 1 Square Feet 1440 Linear Feet 480

No Lines 4 Trench Width 36" Max Trench Bottom Depth 22" Gravel Depth 12"

☒ New System ☐ Repair System Type: I, II, III, IV, V, VI

System Description: gravity conventional

Repair System Description: LPP

Maintenance Agreement Required: ☐ Yes ☒ No

☒ House/Mod. Home No. Bedrooms 3

☐ Mobile Home No. Bathrooms 2

☐ Business No. Employees ____

☐ Other ____


☐ Slab ☒ Crawl Space ☐ Basement w/plumbing ☐ Basement wo/plumbing

Water Supply: ☒ Individual ☐ Community ☐ Public

Comments: do not install during wet soil conditions or rain
direct downspouts away from nit.field

Comments:

INITIAL SITE SKETCH

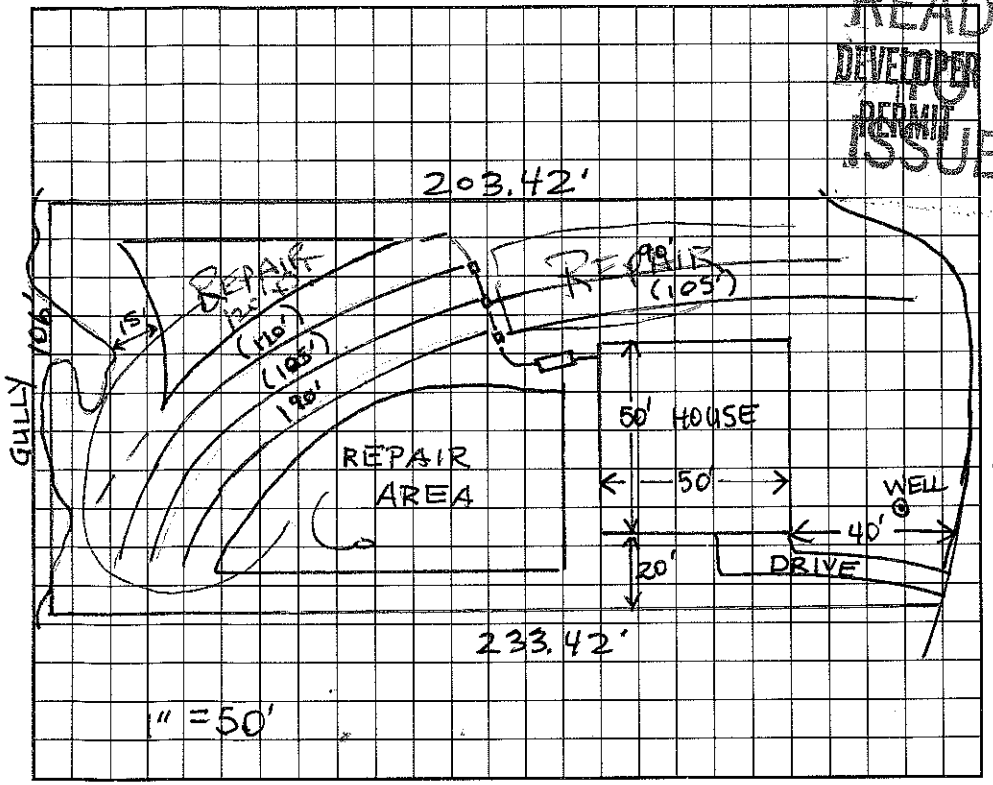

AS BUILT SKETCH

I understand that this permit can be suspended or revoked if any false information is supplied toward securing the permit/any unauthorized changes are made to the site/any unauthorized changes are made in the installation of the system. Improvement Permit is valid for 60 months from date of issuance.

Signed: ____

Improvement Permit by: Andrea Lemon date 3-14-94

Existing System Inspection by: ____ date ____

Installed by: Rowan Septic Tank

Certificate of Completion by: Wesley Sparks R.S. date 1/24/95

Operation Permit by: ____ date ____

HEALTH DEPT. COPY: WHITE INSPECTION COPY (FINAL): GREEN OWNER COPY (FINAL): YELLOW INSPECTION COPY (INITIAL): PINK OWNER COPY (INITIAL): GOLD