IREDELL COUNTY HEALTH DEPARTMENT

STATESVILLE 704-878-5305 MOORESVILLE 704-664-5281

IMPROVEMENT PERMIT / CERTIFICATE OF COMPLETION / OPERATION PERMIT / EXISTING SYSTEM INSPECTION

PROPERTY DESCRIPTION NO. 16161 DATE AUGUST 3 1993 TAX MAP NO. 25-7-A-21

OWNER OR CONTRACTOR SPEAR CONSTRUCTION PHONE: Business 704 636 7954 Home

ADDRESS 607 ANDERSON AVENUE SALISBURY NC 28144

LOCATION ON N/S OF 1302 ~4/10 MILE W/ OF JUDAS RD 4648-08-9313

SUBDIVISION MILLS FOREST BLOCK / SECTION LOT 21 LOT AREA 29,000 SQFT SITE CLASS. P L.T.A.R. 0.3

Water Supply: ☒ Individual ☐ Community ☐ Public

Septic Tank: 1000 Gallons; STB RST 825 Date 7-6-93

Pump Tank: 1000 Gallons; ~~PT~~ ~~Date~~

Nitrification Field: No Fields 1 Square Feet 1200' Linear Feet 400'

No Lines 4 or 3 Trench Width 36" Trench Depth 30" Gravel Depth 12"

☒ New System ☐ Repair System Type: I, II, III, IV, V, VI

System Description: CONVENTIONAL-GRAV. DIST.

Repair System Description: CONV. / PPBPS

Maintenance Agreement Required: ☐ Yes ☒ No

☒ House/Mod. Home No. Bedrooms 3 Garbage Disposal: ☐ Yes ☒ No

☐ Mobile Home No. Bathrooms 2 Auto. Dishwasher: ☒ Yes ☐ No

☐ Business No. Employees Auto. Washing Machine: ☒ Yes ☐ No

☐ Other Other

☐ Slab ☒ Crawl Space ☐ Basement w/plumbing ☐ Basement wo/plumbing

Comments TANK PLACEMENT VARIABLE DEPENDING ON DRIVEWAY. TRENCH DEPTH EXCEEDING 30" WILL REQUIRE ADDITIONAL NIT. LINE. DO NOT INSTALL DURING WET SOIL CONDITIONS OR RAIN. PUMP SIZE CAN BE DETERMINED AFTER TANK PLACEMENT IS DECIDED.

ICHD-Environmental Health Division

The proposed / existing Garage & Office addition does not appear to impact the existing septic system.


**NOTE: Shall be min. 25' to well

Andrea Melville R.S.


Date: 4-10-13

ICHD-Environmental Health Division

INITIAL SITE

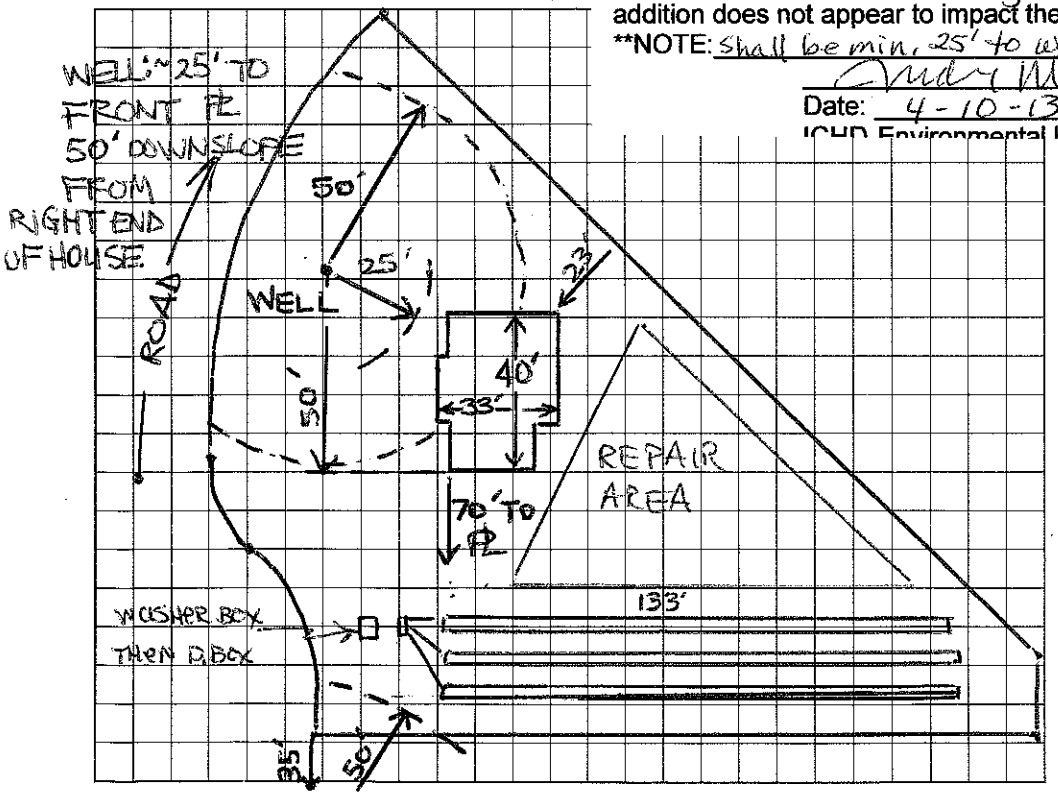

AS BUILT SKETCH

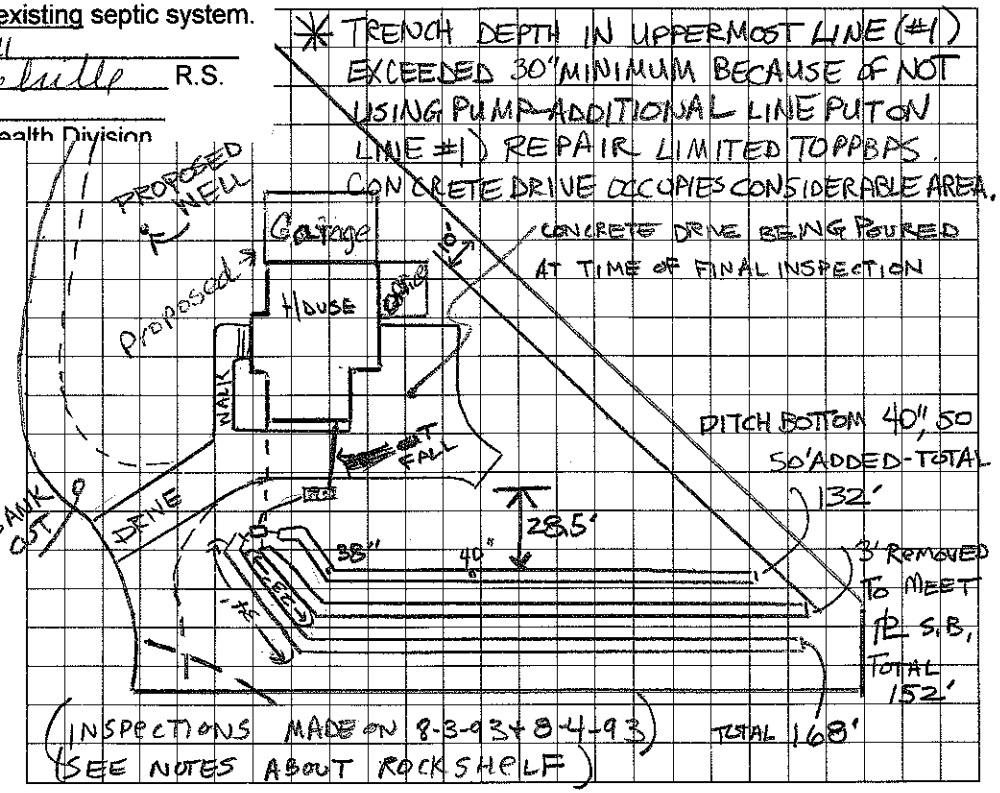

I understand that this permit can be suspended or revoked if any false information is supplied toward securing the permit/any unauthorized changes are made to the site/any unauthorized changes are made in the installation of the system. Improvement Permit is valid for 60 months from date of issuance.

Signed: 8-10-93

LOT 20 WELL

Improvement Permit by: Andrea Lemon date 8-3-93

Existing System Inspection by: date

Installed by: Rowan Septic Tank

Certificate of Completion by: Andrea Lemon date 8-4-93

Operation Permit by: date

HEALTH DEPT. COPY: WHITE INSPECTION COPY (FINAL): GREEN OWNER COPY (FINAL): YELLOW INSPECTION COPY (INITIAL): PINK OWNER COPY (INITIAL): GOLD