IREDELL COUNTY HEALTH DEPARTMENT

STATESVILLE 704-878-5305 MOORESVILLE 704-664-5281

IMPROVEMENT PERMIT / CERTIFICATE OF COMPLETION / OPERATION PERMIT / EXISTING SYSTEM INSPECTION

PROPERTY DESCRIPTION NO. 17296 DATE 3=10=94 TAX MAP NO. 25 A 51 4648 09 6752 Watershed: ☐ Yes ☐ No

OWNER OR CONTRACTOR KROM FINANCIAL SERVICES PHONE: Business 664-3671 Home

ADDRESS 19 Yacht Cove MOoresville NC 28115

LOCATION north side of cornelius road west of judas road

SUBDIVISION MILLS FOREST BLOCK / SECTION II LOT ~~XX~~ 31 LOT AREA 20,000min SITE CLASS. P DESIGN FLOW 360 L.T.A.R. 0,25

Septic Tank: 1000 Gallons; STB 825 Date ~~1000~~ 1/4/95 ☒ New System ☐ Repair System Type: I, II, III, IV, V, VI

Pump Tank: 1087 Gallons; PT 47 Date 11/7/94 System Description: pump conventional

Pump Make: Model Serial No. Repair System Description: LPP

Nitrification Field: No Fields 2 Square Feet 1440 Linear Feet 480 Maintenance Agreement Required: ☐ Yes ☒ No

No Lines 6 Trench Width 36" Max Trench Bottom Depth 22" Gravel Depth 12"

☒ House/Mod. Home No. Bedrooms X3

☐ Mobile Home No. Bathrooms 2

☐ Business No. Employees

☐ Other

☐ Slab ☒ Crawl Space ☐ Basement w/plumbing ☐ Basement wo/plumbing


Water Supply: ☒ Individual ☐ Community ☐ Public

Comments: do not install during wet soil conditions or rain
DO NOT FILL SMALL GULLY AT FRONT OF LOT UNTIL SYSTEM IS INSTALLED/LOCATED.

REPAIR DEVELOPER PERMIT TO ISSUE 11/3/95 AWS

Comments:
installed as drawn on Imp. Permit.

INITIAL SITE SKETCH

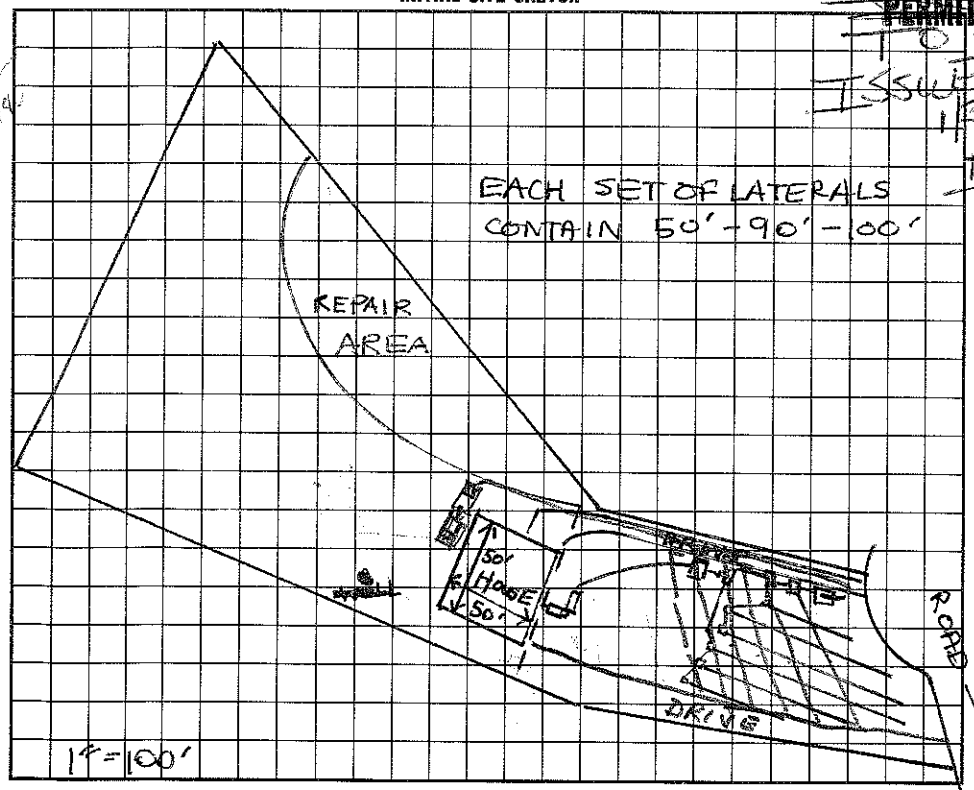

AS BUILT SKETCH

I understand that this permit can be suspended or revoked if any false information is supplied toward securing the permit/any unauthorized changes are made to the site/any unauthorized changes are made in the installation of the system. Improvement Permit is valid for 60 months from date of issuance.

Signed:

Improvement Permit by: Andrea Lemon date 3-11-94

Existing System Inspection by: date

Installed by: Rowan Septic Tank

Certificate of Completion by: Wesley Sparks RS. date 3/15/95

Operation Permit by: date

HEALTH DEPT. COPY: WHITE INSPECTION COPY (FINAL): GREEN OWNER COPY (FINAL): YELLOW INSPECTION COPY (INITIAL): PINK OWNER COPY (INITIAL): GOLD