IREDELL COUNTY HEALTH DEPARTMENT

STATESVILLE 704-878-5305 MOORESVILLE 704-664-5281

IMPROVEMENT PERMIT / CERTIFICATE OF COMPLETION / OPERATION PERMIT / EXISTING SYSTEM INSPECTION

PROPERTY DESCRIPTION NO. 17301 DATE 3-10-94 TAX MAP NO. 25 A 51 4648 09 9968 Watershed: ☐ Yes ☐ No

OWNER OR CONTRACTOR KROM FINANCIAL SERVICES PHONE: Business 664-X 3671 Home

ADDRESS 19 Yacht cove Mooresville NC 28115

LOCATION north side of Cornelius road west of Judas road

SUBDIVISION MILLS FOREST BLOCK / SECTION II LOT 28 LOT AREA 20,000min SITE CLASS. P DESIGN FLOW 360 L.T.A.R. 0.25

Septic Tank: 1000 Gallons; STB 744 Date 2/24/95
Pump Tank: 1000 Gallons; PT 47 Date 3/16/95
Pump Make: Model Serial No.
Nitrification Field: No. Fields 1 Square Feet 1440 Linear Feet 480
No. Lines 45 Trench Width 36" Max Trench Bottom Depth 24" Gravel Depth 12"

☒ New System ☐ Repair System Type: I, II, III, IV, V, VI
System Description: pump conventional
Repair System Description: pump conventional
Maintenance Agreement Required: ☐ Yes ☒ No

☒ House/Mod. Home No. Bedrooms 3
☐ Mobile Home No. Bathrooms 2
☐ Business No. Employees
☐ Other
☐ Slab ☒ Crawl Space ☐ Basement w/plumbing ☐ Basement wo/plumbing


Water Supply:
☒ Individual
☐ Community
☐ Public

Comments: do not install DURING WET SOIL CONDITIONS DRAIN.


READY FOR DEVELOPER PERMIT ISSUE 12/5/94 Mills

Comments:
installed essentially as shown
Tanks off right end of house 5/10/95

INITIAL SITE SKETCH

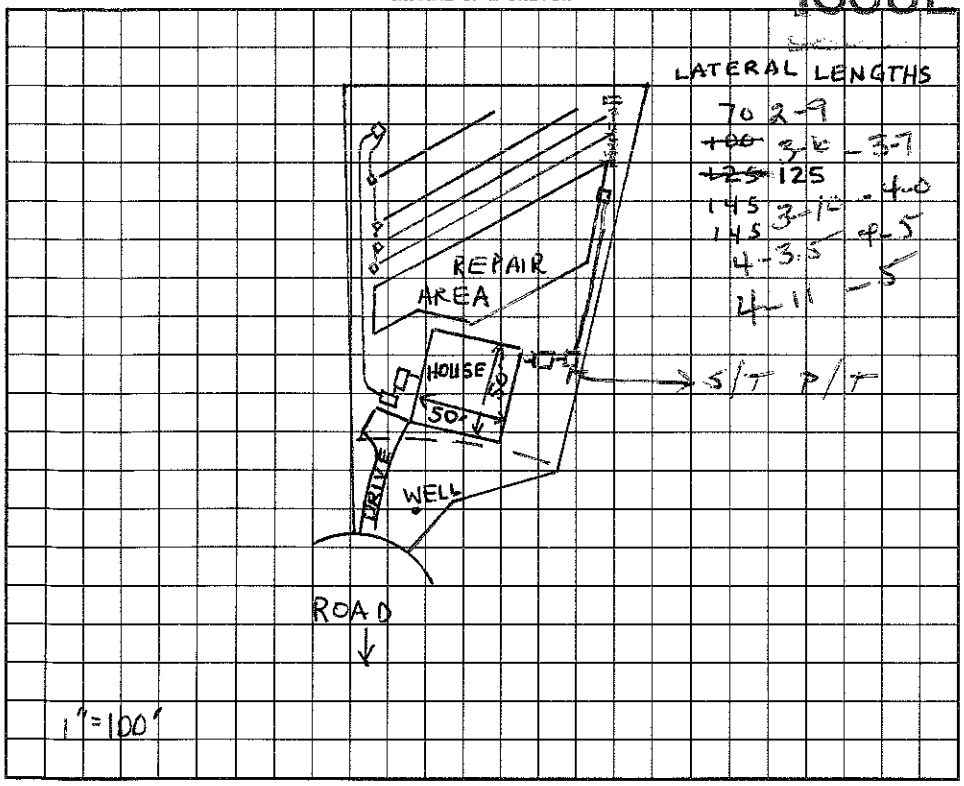

AS BUILT SKETCH

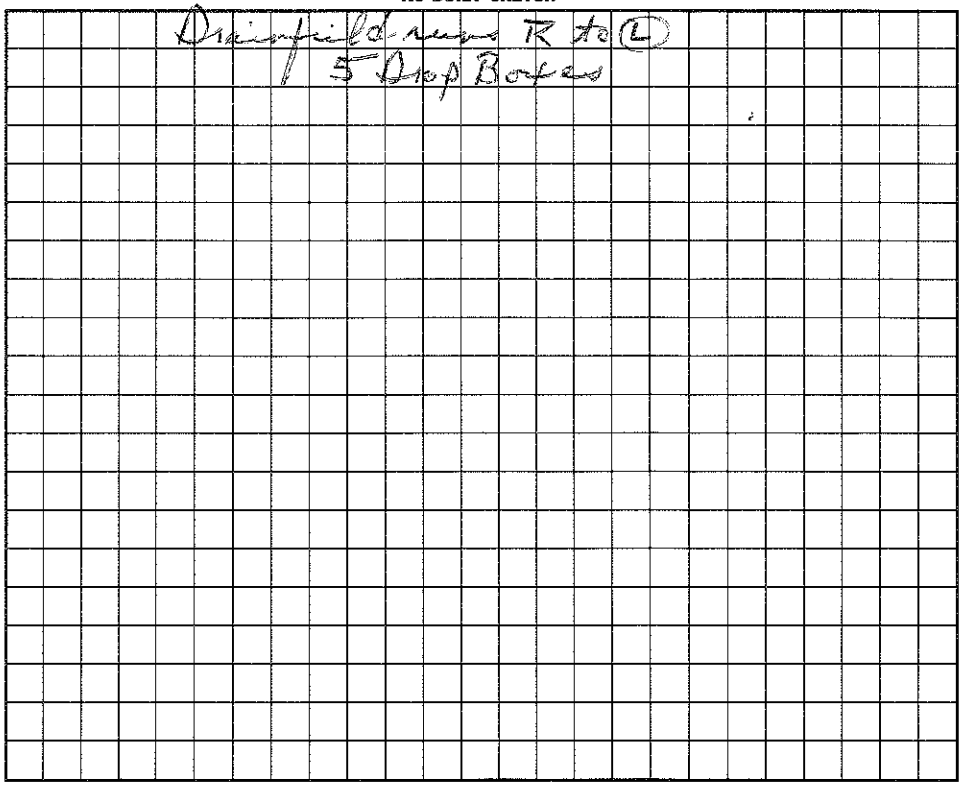

I understand that this permit can be suspended or revoked if any false information is supplied toward securing the permit/any unauthorized changes are made to the site/any unauthorized changes are made in the installation of the system. Improvement Permit is valid for 60 months from date of issuance.

Signed:

Improvement Permit by: Andrea Lemon date 3-11-94

Existing System Inspection by: date

Installed by: Rowan Septic Tank

Certificate of Completion by: Wesley Sparks R.S. date 5/10/95

Operation Permit by: date

HEALTH DEPT. COPY: WHITE INSPECTION COPY (FINAL): GREEN OWNER COPY (FINAL): YELLOW INSPECTION COPY (INITIAL): PINK OWNER COPY (INITIAL): GOLD