IREDELL COUNTY HEALTH DEPARTMENT

STATESVILLE 704-878-5305 MOORESVILLE 704-664-5281

IMPROVEMENT PERMIT / AUTHORIZATION TO CONSTRUCT / OPERATION PERMIT / EXISTING SYSTEM INSPECTION

PERMIT# ~~20766~~ 12862 PIN# 4648-10-0627 DATE 7/14/05

OWNER OR CONTRACTOR Lakevision Dev. / Phil Rotella PHONE: Business 704 506-0907 Home

ADDRESS

LOCATION 150 W, TR Ennis, TR Lynnbrook on Corner

SUBDIVISION Lynnbrook Ac BLOCK / SECTION LOT 19 LOT AREA ±0.5Ac SITE CLASS. PS DESIGN FLOW 480 L.T.A.R. 0.5

Septic Tank: 1000 Gallons; STB 1012 Date 7/14/05
Pump Tank: Gallons; PT Date
Pump Make: Model Serial No.
Nitrification Field: No Fields 1 Square Feet 1200 Linear Feet 400
No Lines 6@67' Trench Width 36" Max Trench Bottom Depth 36" Gravel Depth —

☒ New System ☐ Repair System Type: I, II, III, IV, V, VI
System Description: Gravity 25% Reduct.
Repair System Description: Up Flow Block
Maintenance Agreement Required: ☐ Yes ☒ No

☒ House/Mod. Home No. Bedrooms 4
☐ Mobile Home No. Bathrooms
☐ Business No. Employees
☐ Other
☐ Slab ☒ Crawl Space ☐ Basement w/plumbing ☐ Basement wo/plumbing


Water Supply: ☒ Individual ☐ Public ☐ Community

Comments:/Conditions:

Not to scale

Comments:/Conditions:

INITIAL SITE SKETCH

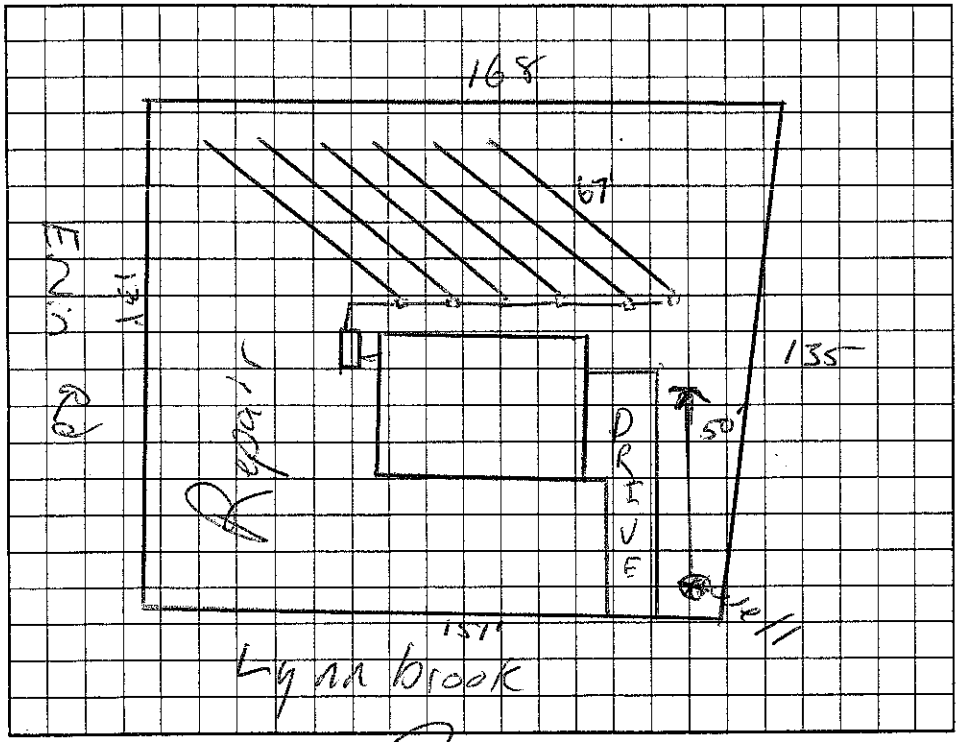

AS BUILT SKETCH

Quick 4 Installed
7 Lines

Permit can be suspended or revoked if any false information is supplied toward securing the permit/any unauthorized changes are made to the site/any unauthorized changes are made in the installation of the system. Improvement Permit with plat valid without expiration. Improvement Permit with site plan valid for sixty months. Authorization to Construct is valid for a period equal to that of Improvement Permit – not to exceed sixty months.

Signed: Deborah A Rotella date 7-15-05 Installed by: GS Grading

Improvement Permit by: RS date 7/14/05 Operation Permit by: RS date 6/28/05

Authorization to Construct by: RS date 7/14/05 Existing System Inspection by: date

HEALTH DEPT. COPY: WHITE OWNER COPY (FINAL): YELLOW OWNER COPY (INITIAL): PINK