IREDELL COUNTY HEALTH DEPARTMENT

STATESVILLE 704-878-5305 MOORESVILLE 704-664-5281

IMPROVEMENT PERMIT / AUTHORIZATION TO CONSTRUCT / OPERATION PERMIT / EXISTING SYSTEM INSPECTION

130.00 Pd. CK

PERMIT# 127442 PIN# 4648 10 3611

OWNER OR CONTRACTOR Spear Bldrs PHONE: Business 704-202-4964 Home DATE 5/2/05

ADDRESS 192 Wildwood Cove Dr Mooresville NC 28117

LOCATION 150 W TR Ensia, TR Lynnbrook, on RF

SUBDIVISION Lynnbrook Acres BLOCK / SECTION LOT 17 LOT AREA 0.467 AC SITE CLASS. PS DESIGN FLOW 360 L.T.A.R. 0.3

Septic Tank: 1000 Gallons; STB 825 Date 7/18/05

Pump Tank: 1000 Gallons; PT 302 Date 6/21/05

Pump Make: Zoeller Model N98 Serial No

Nitrification Field: No Fields 1 Square Feet 900 Linear Feet 300

No Lines 3@100' Trench Width 36" Max Trench Bottom Depth 36" Gravel Depth —

☒ New System ☐ Repair System Type: I, II, III, IV, V, VI

System Description: PM 25% Reduction

Repair System Description: Pump Panel Block

Maintenance Agreement Required: ☐ Yes ☒ No

☒ House/Mod. Home ☐ Mobile Home ☐ Business ☐ Other

No. Bedrooms 3 No. Bathrooms No. Employees

Water Supply: ☒ Individual ☐ Public ☐ Community


☐ Slab ☒ Crawl Space ☐ Basement w/plumbing ☐ Basement wo/plumbing

Comments:/Conditions: DO NOT CUT FOR HOUSE SITE

1" = 50'

Comments:/Conditions:

INITIAL SITE SKETCH

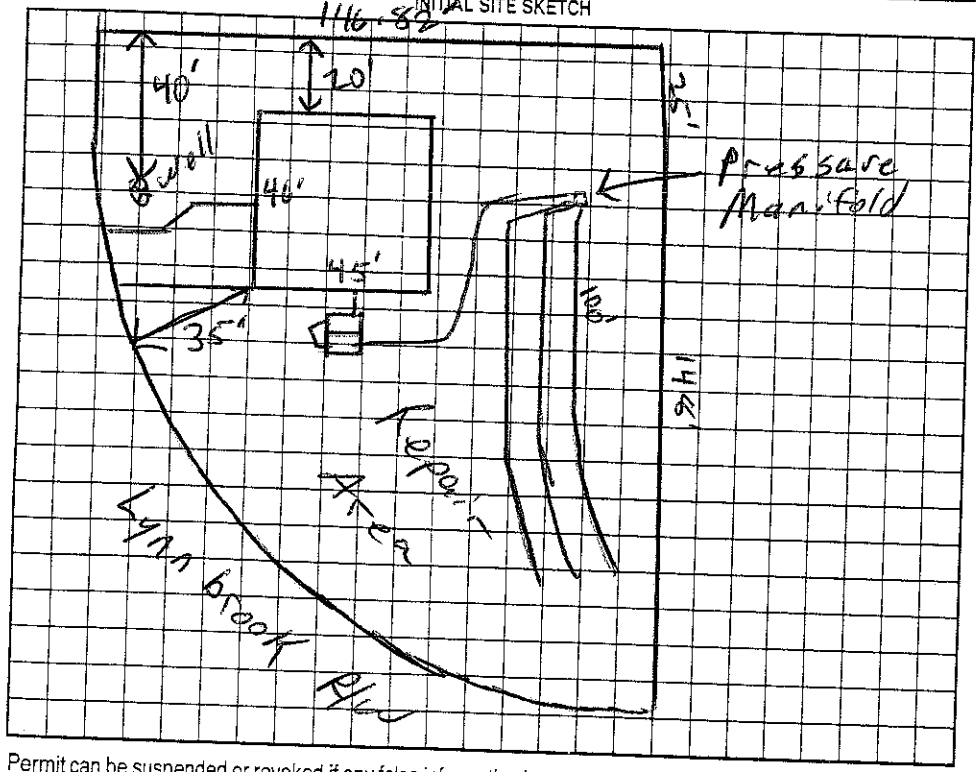

AS BUILT SKETCH

Quick 4 Installed

4 Lines

Permit can be suspended or revoked if any false information is supplied toward securing the permit/any unauthorized changes are made to the site/any unauthorized changes are made in the installation of the system. Improvement Permit with plat valid without expiration. Improvement Permit with site plan valid for sixty months. Authorization to Construct is valid for a period equal to that of Improvement Permit – not to exceed sixty months.

Signed: date 5/3/05 Installed by: Rowan Septic

Improvement Permit by: RS date 5/2/05 Operation Permit by: RS date 10/18/05

Authorization to Construct by: RS date 5/2/05 Existing System Inspection by: date

HEALTH DEPT. COPY: WHITE OWNER COPY (FINAL): YELLOW OWNER COPY (INITIAL): PINK