IREDELL COUNTY HEALTH DEPARTMENT

STATESVILLE 704-878-5305 MOORESVILLE 704-664-5281

IMPROVEMENT PERMIT / CERTIFICATE OF COMPLETION / OPERATION PERMIT / EXISTING SYSTEM INSPECTION

PROPERTY DESCRIPTION NO. 16517 DATE June 17 '93 TAX MAP NO. 2P-1-A-10

OWNER OR CONTRACTOR Charles E. Moore Jr. PHONE: Business 4648-10-5686 Home

ADDRESS Rt 8 / Box 454 / Mooresville / NC

LOCATION 150 W TR Erwin Rd. TR Lynnbrook Ln. on left

SUBDIVISION Lynn brook Acres BLOCK / SECTION LOT 10 LOT AREA SITE CLASS. L.T.A.R.

Water Supply: ☑ Individual ☐ Community ☐ Public

Septic Tank: EX OR NEW 1250 Gallons; STB Date

Pump Tank: Gallons; PT Date

Nitrification Field: No Fields Existing Square Feet Linear Feet

No Lines Trench Width Trench Depth Gravel Depth

☐ New System ☑ Repair System Type: I, II, II, IV, V, VI

System Description: grav. conv.

Repair System Description:

Maintenance Agreement Required: ☐ Yes ☑ No

☑ House/Mod. Home No. Bedrooms 3

☐ Mobile Home No. Bathrooms 3

☐ Business No. Employees

☐ Other

☐ Slab ☐ Crawl Space ☑ Basement w/plumbing ☐ Basement wo/plumbing

Garbage Disposal: ☐ Yes ☐ No


Auto. Dishwasher: ☐ Yes ☐ No

Auto. Washing Machine: ☐ Yes ☐ No


Other

Comments: Addition to house will require movement or replacement of septic tank in order to get 5' minimum separation.

INITIAL SITE SKETCH

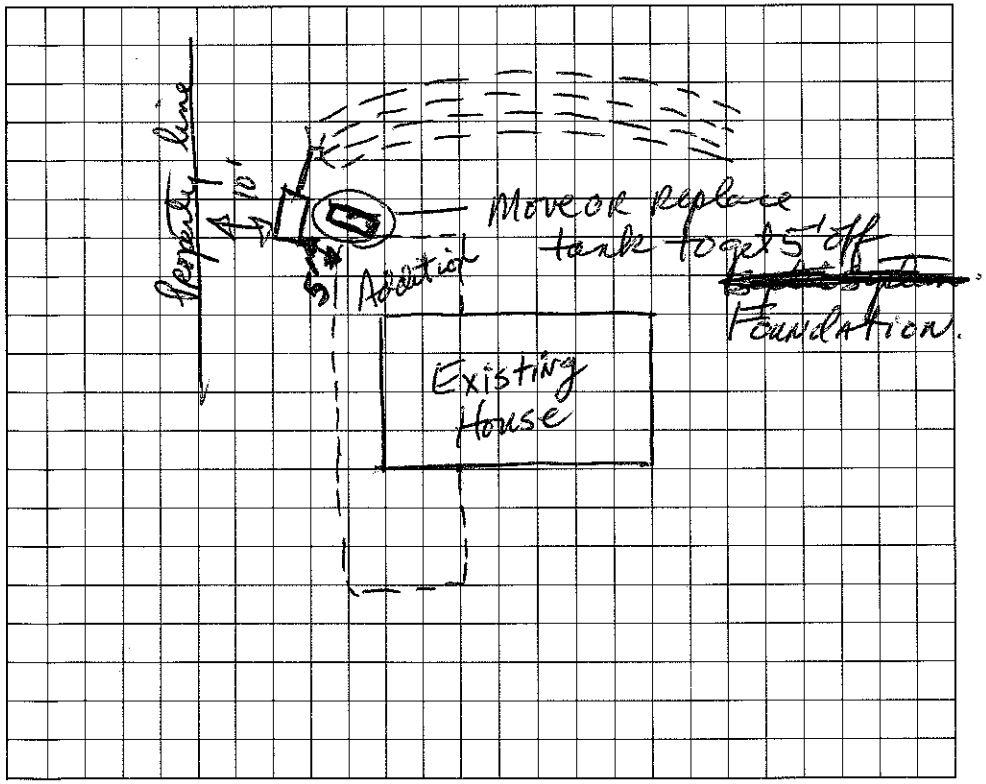

AS BUILT SKETCH

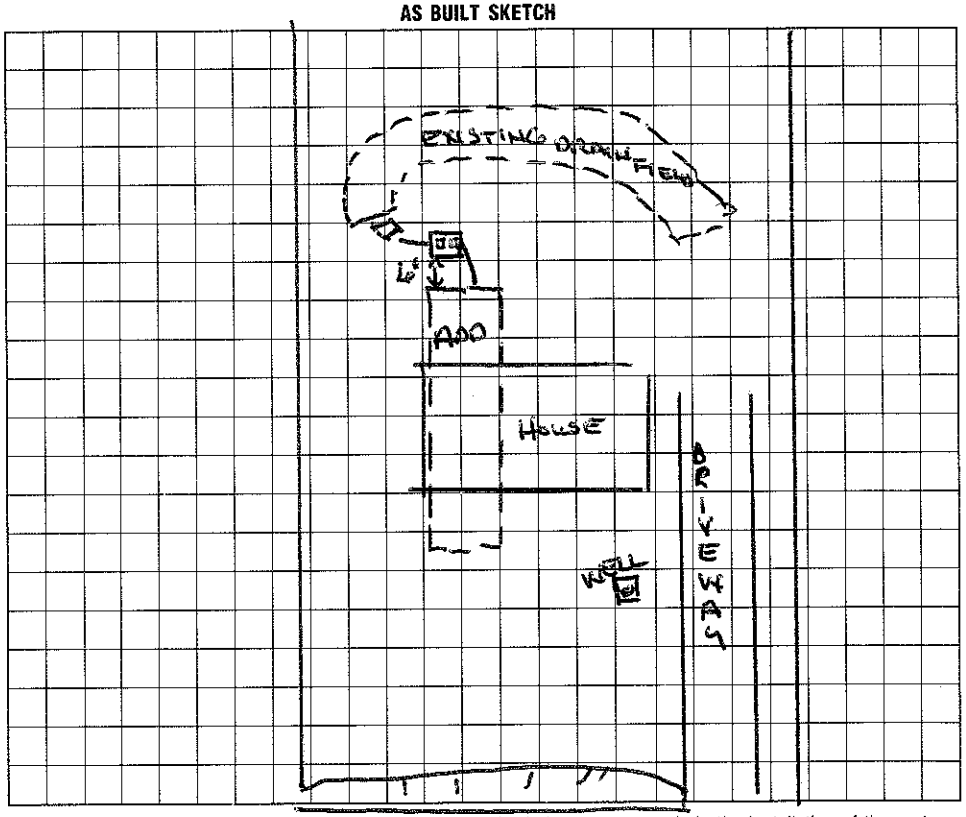

I understand that this permit can be suspended or revoked if any false information is supplied toward securing the permit/any unauthorized changes are made to the site/any unauthorized changes are made in the installation of the system. Improvement Permit is valid for 60 months from date of issuance.

Signed: Charles E. Moore Jr.

Improvement Permit by: Jack Hoffman RS date 6/17/93

Existing System Inspection by: date

Installed by: WAYNE ORBISON LYNNBROOK RD.

Certificate of Completion by: Wesley Sparkes RS date 6/25/93

Operation Permit by: date

HEALTH DEPT. COPY: WHITE INSPECTION COPY (FINAL): GREEN OWNER COPY (FINAL): YELLOW INSPECTION COPY (INITIAL): PINK OWNER COPY (INITIAL): GOLD