11:00

IREDELL COUNTY HEALTH DEPARTMENT

STATESVILLE 704-878-5305 MOORESVILLE 704-664-5281

IMPROVEMENT PERMIT / AUTHORIZATION TO CONSTRUCT / OPERATION PERMIT / EXISTING SYSTEM INSPECTION

PERMIT# 87013 PIN# 4648110924 DATE 2-4-2000

OWNER OR CONTRACTOR Mark & Holly Forester PHONE: Business ~~Mobile Len Beaver~~ 363-8900 Home (336) 605-9566 Holly wk 329-8933

ADDRESS 7102 Taunton Rd Greensboro, NC 27410

LOCATION Hwy 150 W TR Bluefield Rd TL Big Indian Loop Continue Straight to lake #397 ~~Bluefield~~ Big Indian

SUBDIVISION JCL&T BLOCK / SECTION 12 LOT 27 LOT AREA _____ SITE CLASS. PS DESIGN FLOW 480gpd L.T.A.R. - 3

Septic Tank: 1000 Gallons; STB 1012 Date 8-29-00
Pump Tank: 1000 Gallons; PT 17 Date 4-31-00
Pump Make: Gould's Model WE0712H Serial No. B0010531
Nitrification Field: No Fields 1 Square Feet 810 Linear Feet 270
No Lines 3 Trench Width 36" Max Trench Bottom Depth 30"

☒ New System ☐ Repair System Type: I, II, III, IV, V, VI
System Description: Pump - LPP - Panel Blk
Repair System Description: Partial Repair created LOT 1976
Maintenance Agreement Required: ☒ Yes ☐ No

☒ House/Mod. Home ☐ Mobile Home ☐ Business ☐ Other
No. Bedrooms 4 No. Bathrooms 4 No. Employees ____

Gravel Depth N/A ☐ Slab ☐ Crawl Space ☒ Basement w/plumbing ☐ Basement wo/plumbing


Water Supply: ☒ Individual Exist. ☐ Public ☐ Community

Comments:/Conditions: Keep Septic System at least 10' From PL 5' From house & 50' from lake


Comments:/Conditions: Note: Existing well less than 50' from lake. Poly lock Filter installed & riser installed Risers installed. Pressure lines checked 11/3/00

Scale 1:40

INITIAL SITE SKETCH

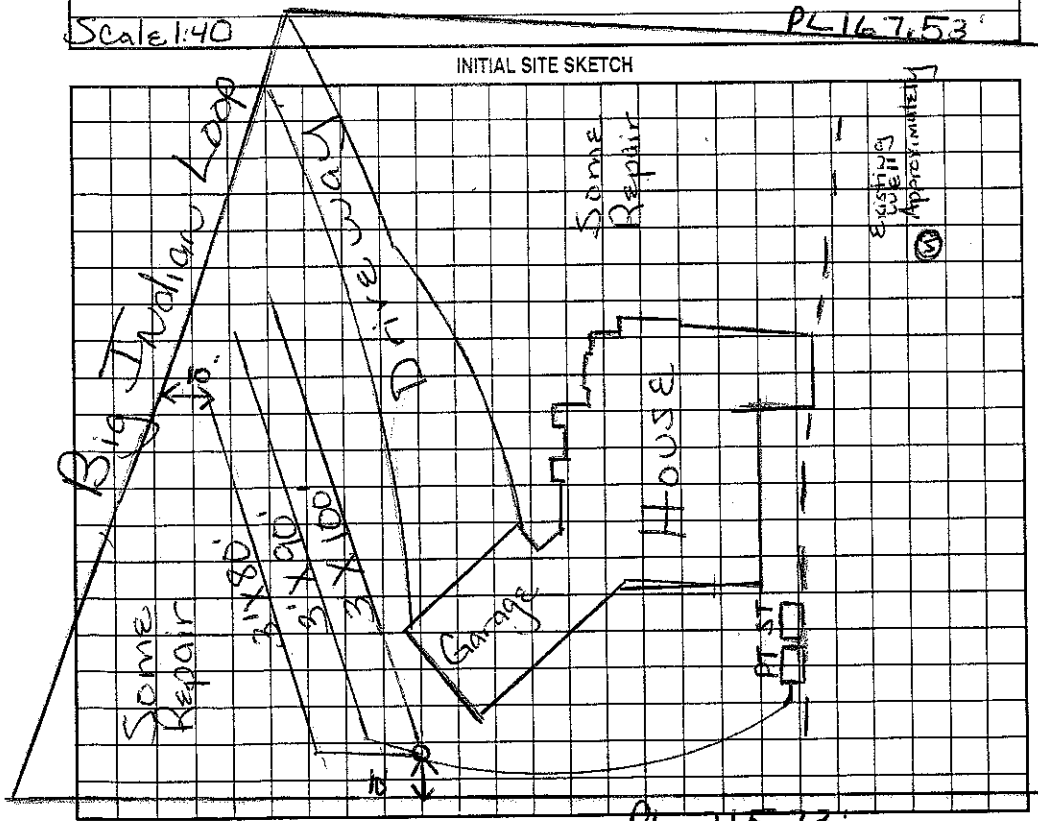

AS BUILT SKETCH

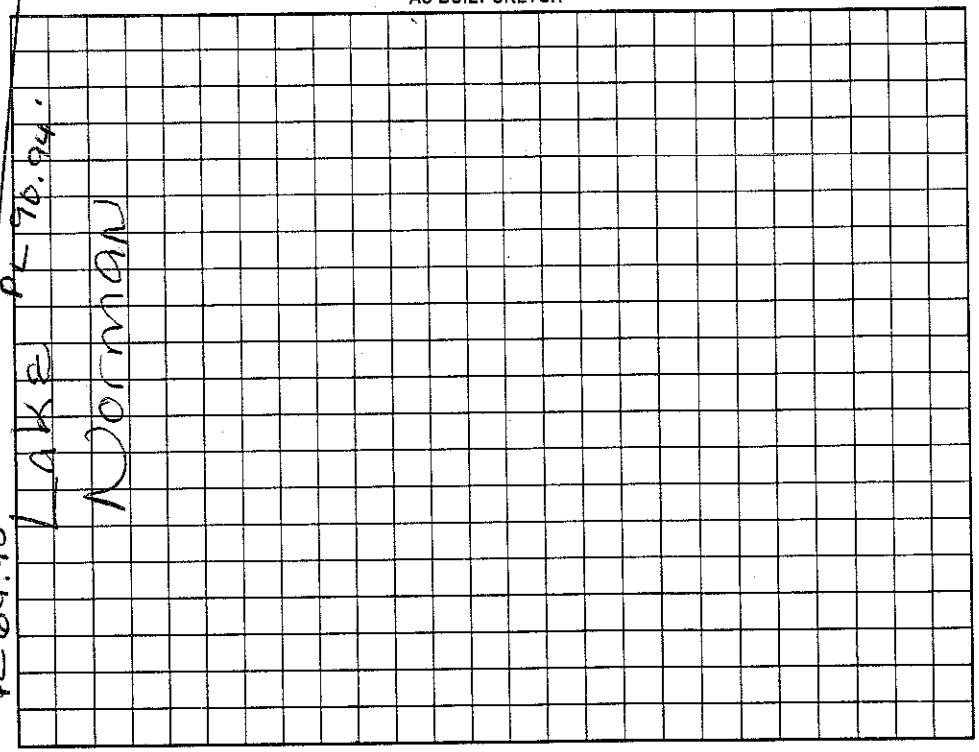

Permit can be suspended or revoked if any false information is supplied toward securing the permit/any unauthorized changes are made to the site/any unauthorized changes are made in the installation of the system. Improvement Permit with plat valid without expiration. Improvement Permit with site plan valid for sixty months. Authorization to Construct is valid for a period equal to that of Improvement Permit – not to exceed sixty months.

Signed: Lewis Beaver date 3/6/00 Installed by: Steve Jordan

Improvement Permit by: Maria H. Dotson RS date 2/14/2000 Operation Permit by: Maria H. Dotson RS date 12/29/2000

Authorization to Construct by: Maria H. Dotson RS date 2/14/2000 Existing System Inspection by: _____ date _____

HEALTH DEPT. COPY: WHITE OWNER COPY (FINAL): YELLOW OWNER COPY (INITIAL): PINK