IREDELL COUNTY HEALTH DEPARTMENT

STATESVILLE 704-878-5305 MOORESVILLE 704-664-5281

IMPROVEMENT PERMIT / ~~CERTIFICATE OF COMPLETION~~ / OPERATION PERMIT / EXISTING SYSTEM INSPECTION

4648114805 300-400

PROPERTY DESCRIPTION NO. Repair DATE 4/29/96 TAX MAP NO. 4648114805 Watershed: ☑ Yes ☐ No

OWNER OR CONTRACTOR Charles Ball PHONE: Business _____ Home 663-2208

ADDRESS 381 Big Indian Loop

LOCATION 150 w FR Bluebell - TL Big Indian Loop on left Before Lake Norman

SUBDIVISION _____ BLOCK / SECTION _____ LOT _____ LOT AREA 197 ac SITE CLASS PS DESIGN FLOW 360 gpd L.T.A.R. 3 gpd

Septic Tank: existing Gallons; STB _____ Date _____

Pump Tank: _____ Gallons; PT _____ Date _____

Pump Make: _____ Model _____ Serial No. _____

Nitrification Field: No. Fields 1 Square Feet 500 Linear Feet 40

No Lines Bed Trench Width 10' Max Trench Bottom Depth 36" Gravel Depth 24"

☐ New System ☑ Repair System Type: I, II, III, IV, V, VI

System Description: Gravity Conventional Bed

Repair System Description: _____

Maintenance Agreement Required: ☐ Yes ☑ No

☑ House/Mod. Home No. Bedrooms 3

☐ Mobile Home No. Bathrooms 2

☐ Business No. Employees _____

☐ Other _____


☐ Slab ☐ Crawl Space ☑ Basement w/plumbing ☑ Basement wo/plumbing

Water Supply: ☑ Individual ☐ Community ☐ Public

Comments:

Comments:

INITIAL SITE SKETCH

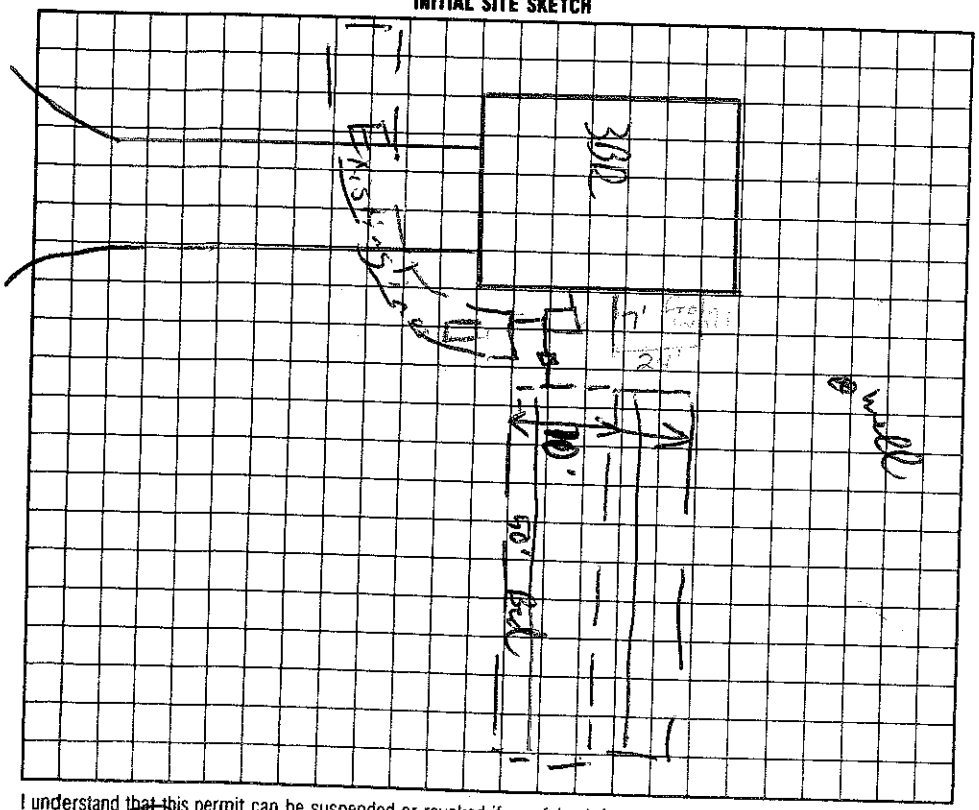

AS BUILT SKETCH

SAME AS SKETCH

I understand that this permit can be suspended or revoked if any false information is supplied toward securing the permit/any unauthorized changes are made to the site/any unauthorized changes are made in the installation of the system.

Signed: Beverly E Ball

Improvement Permit by: C. Rudy Freeman REHS date 4/29/96

~~Existing System Inspection~~ by: C. Rudy Freeman REHS date 4/29/96

Installed by: BARRY THOMPSON

Certificate of Completion by: _____ date _____

Operation Permit by: C. Rudy Freeman date 1/19/97

HEALTH DEPT. COPY: WHITE INSPECTION COPY (FINAL): GREEN OWNER COPY (FINAL): YELLOW INSPECTION COPY (INITIAL): PINK OWNER COPY (INITIAL): GOLD

IREDELL COUNTY HEALTH DEPARTMENT

STATESVILLE 704-878-5305 MOORESVILLE 704-664-5281

IMPROVEMENT PERMIT / CERTIFICATE OF COMPLETION / OPERATION PERMIT / EXISTING SYSTEM INSPECTION

PROPERTY DESCRIPTION NO. Repair DATE 4/12/96 TAX MAP NO. Watershed: ☑ Yes ☐ No

OWNER OR CONTRACTOR Charles Ball PHONE: Business Home 663-2208

ADDRESS 381 Big Indian Loop

LOCATION 150 W FR Bluefield – TL Big Indian Loop on Left before Indian Norman

SUBDIVISION BLOCK / SECTION LOT LOT AREA .97ac SITE CLASS. PS DESIGN FLOW 360 L.T.A.R. .3gpd/ft²

Septic Tank: 1000-Exist Gallons; STB Date

Pump Tank: 1000 Gallons; PT Date

Pump Make: Model Serial No.

Nitrification Field: No Fields 1 Square Feet 600 Linear Feet 200

No Lines 5 Trench Width 36" Max Trench Bottom Depth 36" Gravel Depth N/A

☐ New System ☑ Repair System Type: I, II, III, IV, V, VI

System Description: Pump Panel

Repair System Description:

Maintenance Agreement Required: ☑ Yes ☐ No

☑ House/Mod. Home No. Bedrooms 3

☐ Mobile Home No. Bathrooms 2

☐ Business No. Employees

☐ Other


☐ Slab ☐ Crawl Space ☐ Basement w/plumbing ☑ Basement wo/plumbing

Water Supply: ☑ Individual ☐ Community ☐ Public


Comments: STAY 50' FROM Well with any part of Septic System. Abandon old System.

Comments:

INITIAL SITE SKETCH

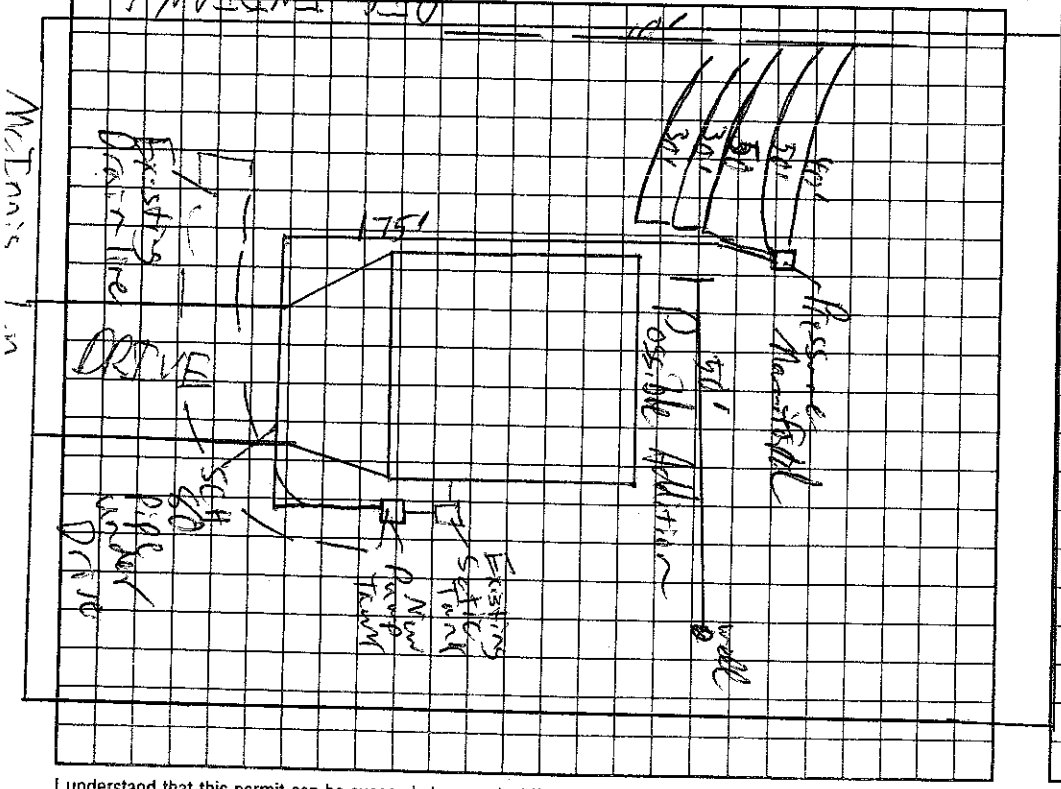

AS BUILT SKETCH

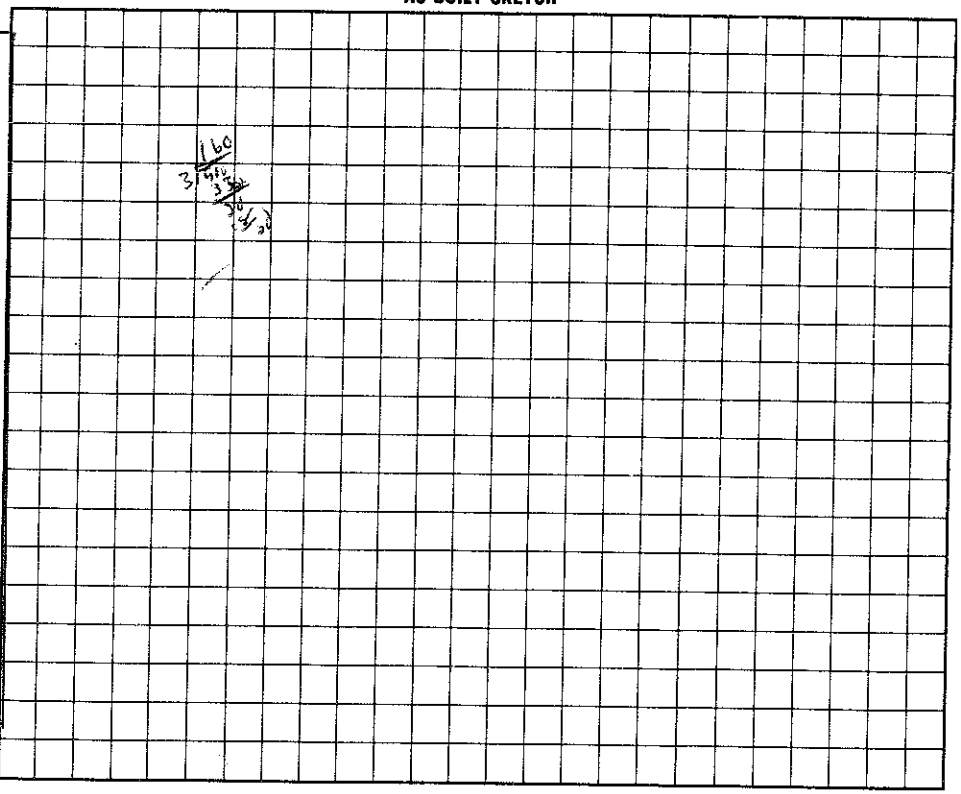

I understand that this permit can be suspended or revoked if any false information is supplied toward securing the permit/any unauthorized changes are made to the site/any unauthorized changes are made in the installation of the system.

Signed: Beverly E Ball

Improvement Permit by: date 4/12/96

Existing System Inspection by: date 4/12/96

Installed by:

Certificate of Completion by: date

Operation Permit by: date

HEALTH DEPT. COPY: WHITE INSPECTION COPY (FINAL): GREEN OWNER COPY (FINAL): YELLOW INSPECTION COPY (INITIAL): PINK OWNER COPY (INITIAL): GOLD