IREDELL COUNTY HEALTH DEPARTMENT

Statesville Office (704) 878-5305 Mooresville Office (704) 660-3625 PERMIT # 209658

IMPROVEMENT PERMIT / AUTHORIZATION TO CONSTRUCT / OPERATION PERMIT / EXISTING SYSTEM

PIN # 4648-11-5640.000

APPLICANT: WINDSWEPT CONSTRUCTION APPLICANT ADDRESS: 4010 WINDSWEPT RD. CONCORD, NC 28027

SITE ADDRESS: 116 MCINNIS RD. MOORESVILLE NC PHONE: — ALT. PHONE: —

SITE DIRECTIONS: 150 W, TR BUCKFIELD, TL BIG INDIAN LP. TL MCINNIS, SITE ON R

SUBDIVISION: JW STOTTS SECTION: — LOT # 4 LOT AREA: .505 ACRE DESIGN FLOW: EX. 360 GAL L.T.A.R.: EXISTING

Septic Tank EXISTING (gal) STB — Date —
Pump Tank — (gal) PT — Date —
Pump Make — Model — Serial # —
Nitrification Fields EX. # Lines EXISTING Linear Ft: EXISTING
Trench Width EXISTING Max. Trench Bottom Depth EXISTING Gravel Depth EXISTING

☐ New System ☐ Repair ☐ Expansion System Type: I (II) III IV V VI
System Description: EXISTING CONVENTIONAL BED
Repair System Description: EXISTING
Maintenance Agreement Required: ☐ YES ☒ NO
☒ GRAVITY ☐ PRESSURE

☒ Residence No. Bedrooms EX. 3
☐ Business No. Persons EX. 6
☐ Other No. Employees —
☐ Slab ☒ Crawl Space
☐ Basement w/plumbing ☐ Basement w/o plumbing

Water Supply: ☒ Private ☐ Public ☐ Community

Comments / Conditions: SYSTEM APPEARED TO BE FUNCTIONING AT TIME OF INSPECTION.

KEEP HOUSE AND BUILDING STRUCTURES AT LEAST 5' FROM ANY SEPTIC AND COMPONENTS.

INITIAL SITE SKETCH

AS BUILT SKETCH

SEE ATTACHED APPROVED EXISTING SYSTEM DRAWING BY MICHAEL ATHANAS & ASSOCIATES

DATED APPROVED JUN 01 2015

Permit can be suspended or revoked if any false information is supplied toward securing the permit / any unauthorized changes are made to the site / any unauthorized changes are made in the installation of the system. **CONTACT A LOCATOR SERVICE PRIOR TO ANY EXCAVATION**


☐ **IMPROVEMENT PERMIT** *with plat valid without expiration.* ☐ **IMPROVEMENT PERMIT** *with site plan valid for 60 mos.* ☐ **AUTHORIZATION TO CONSTRUCT** *valid for period equal to IMPROVEMENT PERMIT--not to exceed 60 mo.*

Owner / Applicant Signature: [signature] Date: 6/8/15 Installed by: —

IMPROVEMENT PERMIT by: — Date: — OPERATION PERMIT by: — Date: APPROVED JUN 01 2015

AUTHORIZATION TO CONSTRUCT by: — Date: — Existing System Inspected by: [signature] Date: —

Health Dept. Copy - WHITE Applicant (Final Approval) - YELLOW Applicant (Conditional Approval) - PINK

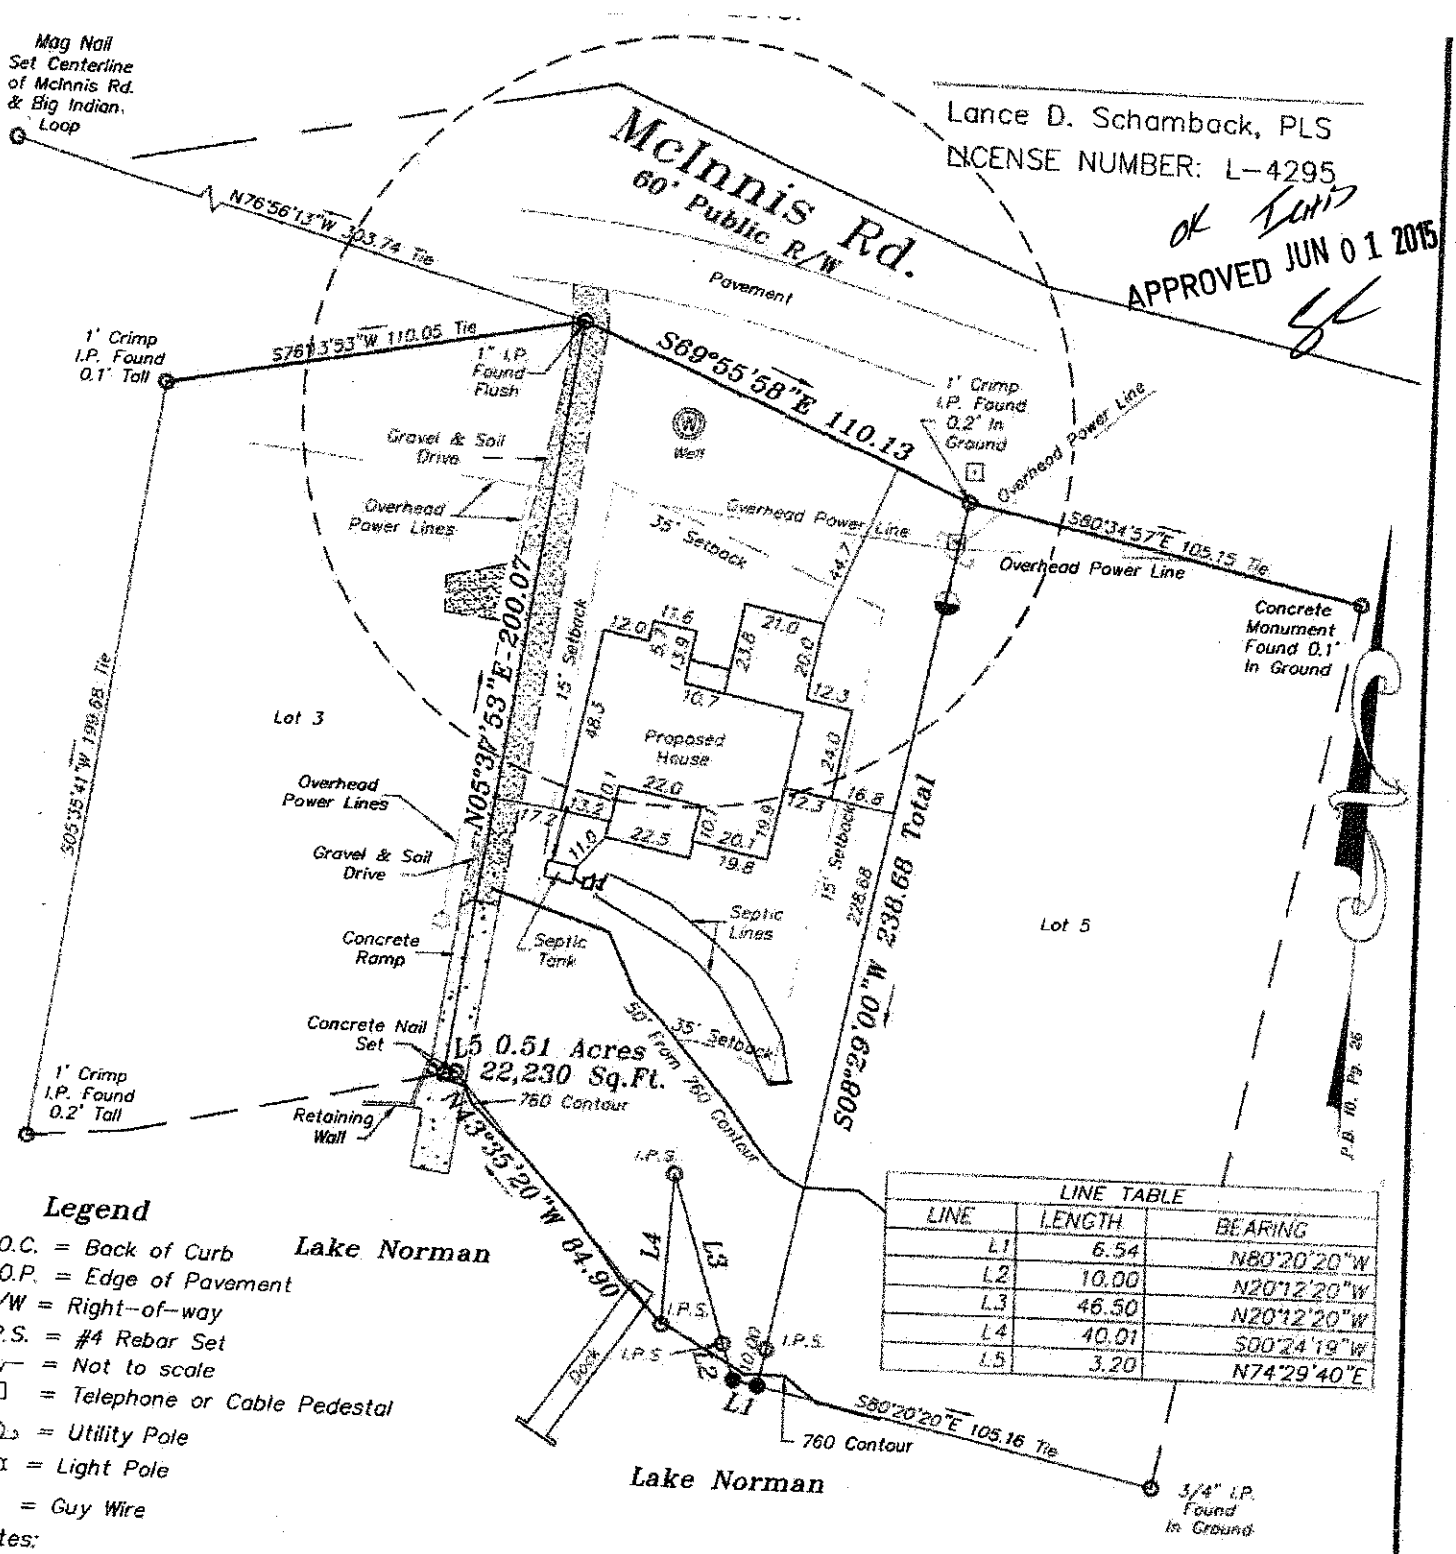

Lance D. Schamback, PLS
LICENSE NUMBER: L-4295

ok Tmp
APPROVED JUN 01 2015

LINE TABLE		
LINE	LENGTH	BEARING
L1	6.54	N80°20'20"W
L2	10.00	N20°12'20"W
L3	46.50	N20°12'20"W
L4	40.01	S00°24'19"W
L5	3.20	N74°29'40"E

Legend

B.O.C. = Back of Curb
E.O.P. = Edge of Pavement
R/W = Right-of-way
I.P.S. = #4 Rebar Set
—∿— = Not to scale
⊡ = Telephone or Cable Pedestal
= Utility Pole
☼ = Light Pole
= Guy Wire

Notes:


1) This property may be subject to any Easements, Rights-of-way, and/or Restrictive Covenants.
2) Boundary information based on Map Book: 10 at Page: 26 as recorded in the Iredell County Register of Deeds.
4) This survey is of an existing parcel or parcels of land.
5) No N.C.G.S. or U.S.G.S. Monuments could be located within 2000'
6) Area by coordinate method.

GRAPHIC SCALE

50 0 25 50 100

(IN FEET)
1 inch = 50 ft.

Vicinity Map

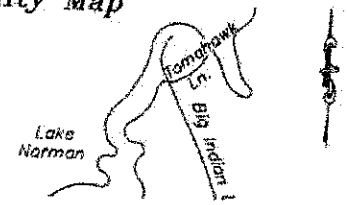

Plot Plan

FOR

Furr Residence

SCALE: 1" = 50

FIELD BOOK:

FILE: 2014-33PLOT