Site Address: 419 Big Indian Lp, Mrsvl.

owes 725.00

pd 10-24-08 SC

IREDELL COUNTY HEALTH DEPARTMENT

STATESVILLE 704-878-5305 MOORESVILLE 704-664-5281

IMPROVEMENT PERMIT / AUTHORIZATION TO CONSTRUCT / OPERATION PERMIT / EXISTING SYSTEM INSPECTION

PERMIT # 153000 209423 PIN # 4648120412.000 DATE 10/22/08

OWNER or APPLICANT Tyler K. Chisholm PHONE: Business 704 896-3651 Home:

OWNER or APPLICANT ADDRESS 819 Northeast Dr. Apt 73 Davidson NC 28036

LOCATION / DIRECTIONS Hwy 150 W TR Bluefield Rd TL Big Indian Lp btw 429 and 411 Big Indian Lp.

SUBDIVISION CL & T BLOCK / SECTION 12 LOT # 1073 LOT AREA .97ac DESIGN FLOW 480 L.T.A.R. .3


Septic Tank	1000	Gallons: STB	794	Date	9-14-14	☑ New System	☐ Repair	☐ Expansion System	Type I II III (IV) V VI
Pump Tank	1000	Gallons: PT	27	Date	9-5-15	System Description: LP- PPBPS			
Pump Make	Myers	Model	ME50S	Serial #	102309	Repair System Description: Same			
Nitrification Field	No Fields 1	No Lines 5		Linear Feet	270'	Maintenance Agreement Required	☑ YES	☐ NO	
Trench Width	24-36"	Max. Trench Bottom Depth		36"	Gravel Depth	N/A	☐ GRAVITY	☑ PRESSURE	

☑ Residence	No. Bedrooms 4	Water Supply	
☐ Business	No. Persons	☑ Private	
☐ Other	No. Employees	☐ Public	
☐ Slab	☐ Crawl Space	☐ Community	
☑ Basement w/plumbing	☐ Basement w/o plumbing		

Comments / Conditions

Lake 195' 1"=50' Scale 79'

INITIAL SITE SKETCH

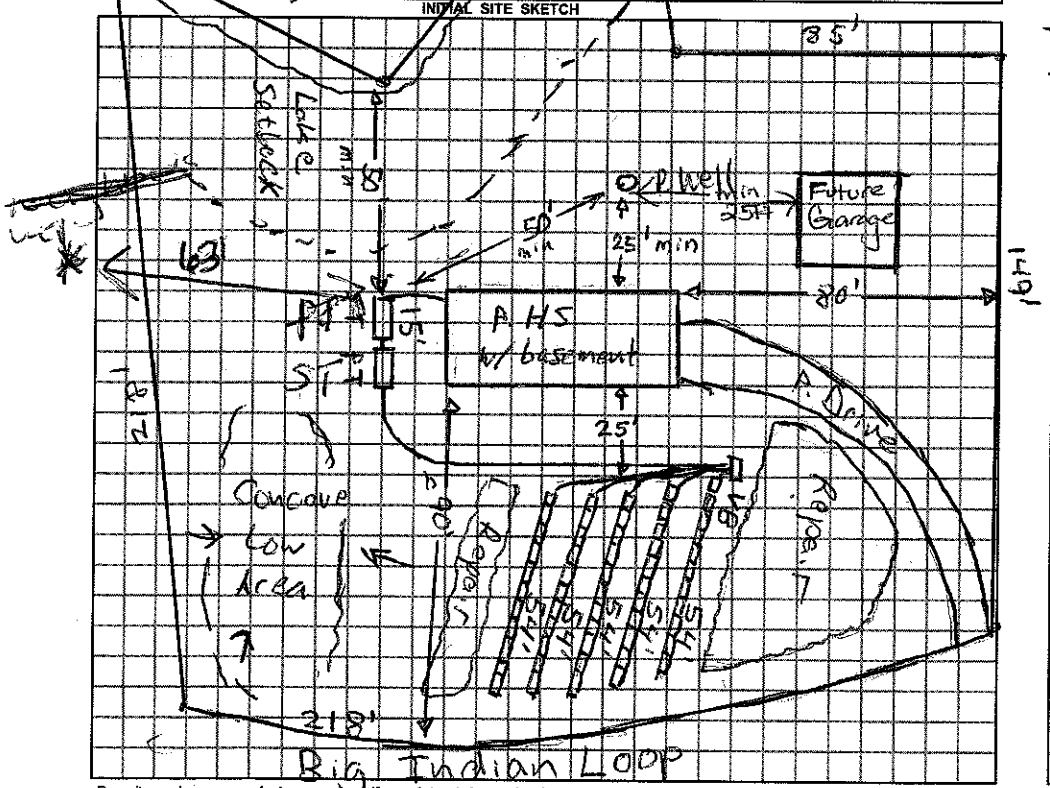

Comments / Conditions Install (5)54' = 12 panels each line

Stay 50' min from Lake setback from Tanks

3/28/15 Reviewed floor plans, in compliance with LP

AS BUILT SKETCH

★ Must keep house 90ft back from PL of road to allow for drainfield 25ft setback btw. Drainfield & basement

21' from Tanks to house

3/16" hole drilled

Note: Some yellow brn dirt in trenches at end near road.

10/16/15 Checked tanks, lines & set 2ft

1/28/16 Checked electr & alarm Pressure Rmvd

Permit can be suspended or revoked if any false information is supplied toward securing the permit / any unauthorized changes are made to the site / any unauthorized changes are made in the installation of the system.

☐ IMPROVEMENT PERMIT w / plat valid without expiration. ☑ IMPROVEMENT PERMIT w / site plan valid for 60 mos. ☐ AUTHORIZATION TO CONSTRUCT valid for period equal to IMPROVEMENT PERMIT-not to exceed 60 mo.

Owner / Applicant Signature: Date 10/24/08

Improvement Permit by: Anthony Cobern RS Date 10/22/08

Authorization to Construct by: Maria H Colson RS Date 3/28/15

Installed by: L. Wayne Orbison

Operation Permit by: Maria H Colson Date: 11/29/16

Existing System Inspected by: Date:

YOU SHOULD CONTACT A LOCATOR SERVICE PRIOR TO ANY EXCAVATION.

WHITE COPY Environmental Health YELLOW COPY (Final) Owner / Applicant PINK COPY (Initial) Owner / Applicant