IREDELL COUNTY HEALTH DEPARTMENT

STATESVILLE 704-878-5305 130.00 Fee MOORESVILLE 704-664-5281

IMPROVEMENT PERMIT / AUTHORIZATION TO CONSTRUCT / OPERATION PERMIT / EXISTING SYSTEM INSPECTION

PERMIT# 116021 PIN# 4648 12 2521 DATE 10/14/03

OWNER OR CONTRACTOR Tom Lawley PHONE: Business 704-361-3130 Home

ADDRESS PO Box 428 Harmony, NC. 28075

LOCATION 150 N TR Bluefield Rd. To Big Indian Loop, straight past Mc Ennis around curve on (R) elbow road

SUBDIVISION Indian Forest BLOCK / SECTION LOT 10 LOT AREA .75 Ac SITE CLASS. PS DESIGN FLOW 360 L.T.A.R. .3

Septic Tank: 1000 Gallons; STB 1012 Date 12/2/03
Pump Tank: 1000 Gallons; PT 19 Date 12/19/03
Pump Make: Goulds Model PE 3IM Serial No. 4/22/02 Discharge
Nitrification Field: No Fields 1 Square Feet 900 Linear Feet 300 x
No Lines 4 @ 75' Trench Width 3' Max Trench Bottom Depth 3' Gravel Depth N/A

[X] New System [ ] Repair System Type: I, II, (III), IV, V, VI
System Description: Pressure to 25% Reduced
Repair System Description: Pressure to 16" PPBPS
Maintenance Agreement Required: [ ] Yes [X] No

[X] House/Mod. Home No. Bedrooms 3
[ ] Mobile Home No. Bathrooms 3
[ ] Business No. Employees
[ ] Other


[ ] Slab [X] Crawl Space [ ] Basement w/plumbing [ ] Basement wo/plumbing

Water Supply: [X] Individual [ ] Public [ ] Community

Comments:/Conditions: * 25% Reduced Drainfield Material Required

Comments:/Conditions:

INITIAL SITE SKETCH (1" = 50')

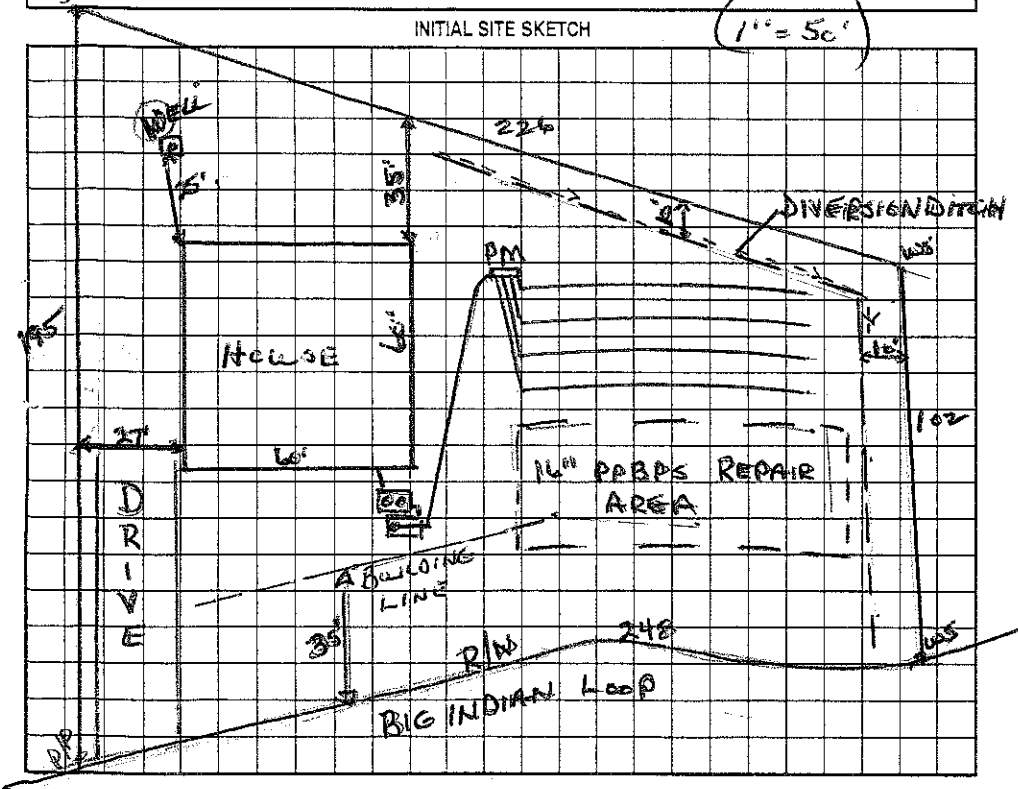

AS BUILT SKETCH

Permit can be suspended or revoked if any false information is supplied toward securing the permit/any unauthorized changes are made to the site/any unauthorized changes are made in the installation of the system. Improvement Permit with plat valid without expiration. Improvement Permit with site plan valid for sixty months. Authorization to Construct is valid for a period equal to that of Improvement Permit – not to exceed sixty months.

Signed: X Tom Lawley date 10-24-03 Installed by: A-1 Backhoe

Improvement Permit by: Wesley Sparks R.S. date 10/23/03 Operation Permit by: Wesley Sparks R.S. date 6/11/04

Authorization to Construct by: Wesley Sparks R.S. date 10/23/03 Existing System Inspection by: date

HEALTH DEPT. COPY: WHITE OWNER COPY (FINAL): YELLOW OWNER COPY (INITIAL): PINK