IREDELL COUNTY HEALTH DEPARTMENT

AUTHORIZATION TO CONSTRUCT

4694811683 4

STATESVILLE 704-878-5305 MOORESVILLE 704-664-5281

IMPROVEMENT PERMIT / ~~CERTIFICATE OF COMPLETION~~ / OPERATION PERMIT / EXISTING SYSTEM INSPECTION

PROPERTY DESCRIPTION NO. 22097 DATE 10/3/95 TAX MAP NO. 2P B 58 Watershed: ☒ Yes ☐ No

OWNER OR CONTRACTOR Mark Stutts PHONE: Business _____ Home 664-9141

ADDRESS 367 Big Indian Loop Mooresville, NC 28115

LOCATION Big Indian Loop on (L) # 367

SUBDIVISION N/A BLOCK / SECTION _____ LOT N/A LOT AREA ~2.88 AC SITE CLASS. PS DESIGN FLOW 360 L.T.A.R. .3

Septic Tank: 1000 Gallons; STB 794 Date 11/29/95

Pump Tank: _____ Gallons; PT _____ Date _____

Pump Make: _____ Model _____ Serial No. _____

Nitrification Field: No. Fields 1 Square Feet 1200 Linear Feet * 300

No Lines 3 or (4) Trench Width 36" Max Trench Bottom Depth 36" Gravel Depth N/A

☒ New System ☐ Repair System Type: I, II, (III) IV, V, VI

System Description: Presby Infiltrator

Repair System Description: _____

Maintenance Agreement Required: ☐ Yes ☒ No

☒ House/Mod. Home No. Bedrooms 3

☐ Mobile Home No. Bathrooms 3

☐ Business No. Employees _____

☐ Other _____


☐ Slab ☒ Crawl Space ☐ Basement w/plumbing ☐ Basement wo/plumbing

Water Supply: ☒ Individual ☐ Community ☐ Public


Comments: * 25% reduction for infiltrator use

Comments: Installed essentially as drawn on Improvement Permit

INITIAL SITE SKETCH

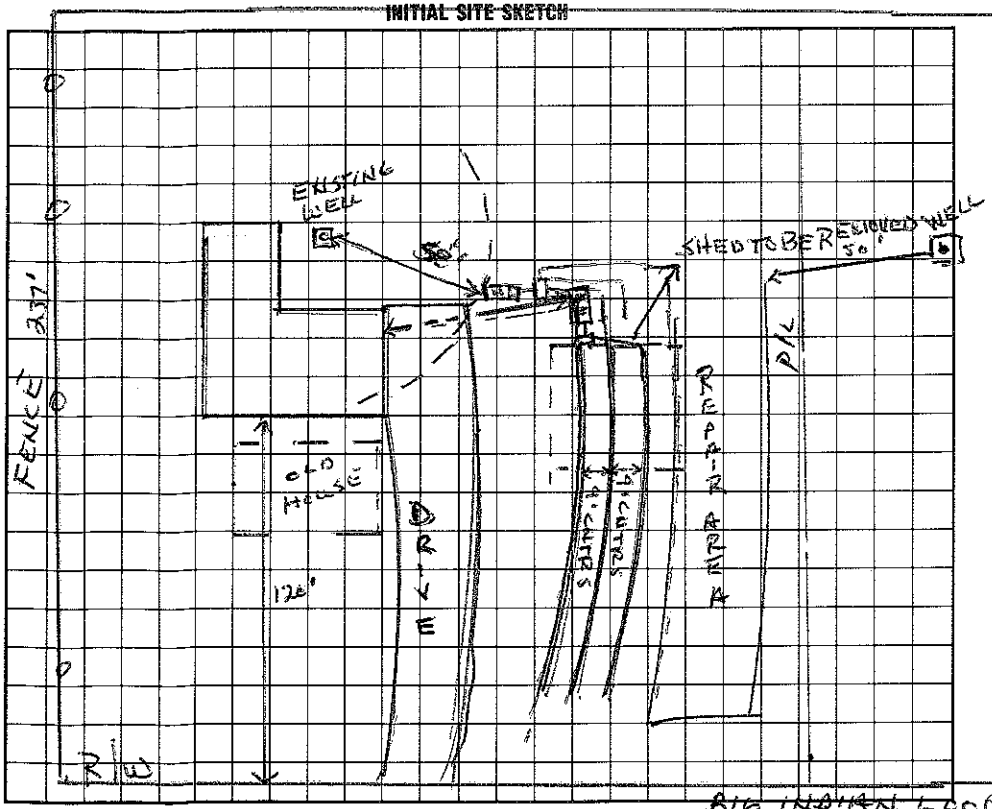

AS BUILT SKETCH

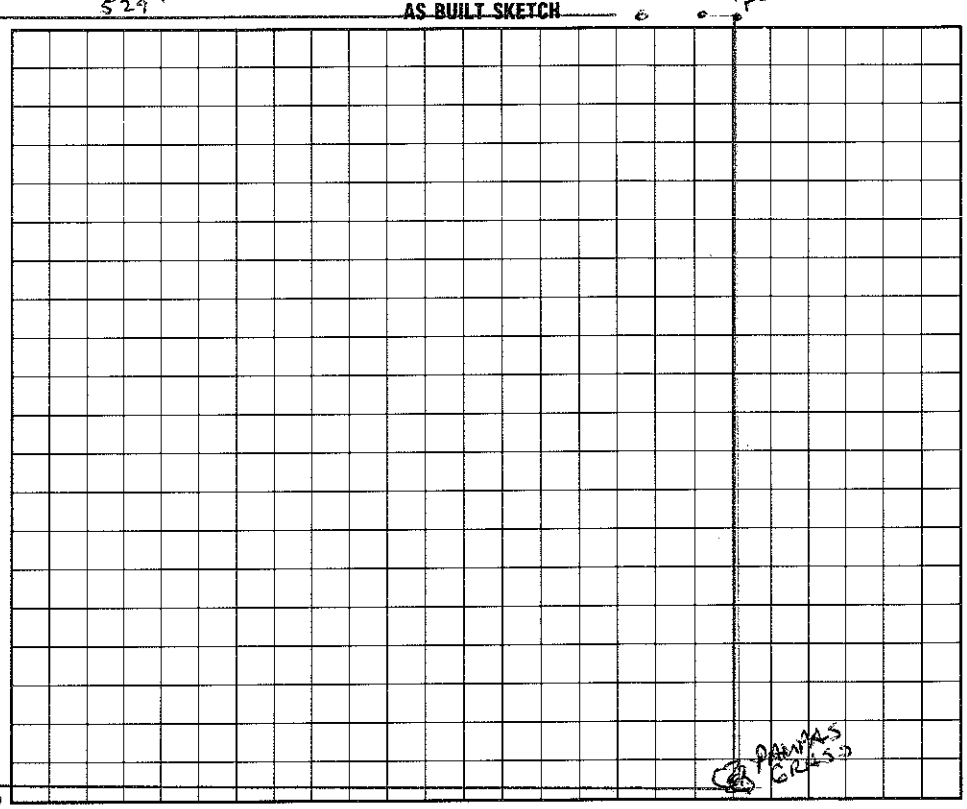

BIG INDIAN LOOP

I understand that this permit can be suspended or revoked if any false information is supplied toward securing the permit/any unauthorized changes are made to the site/any unauthorized changes are made in the installation of the system.

Authorization to construct has 5 year validity from issue date. Improvement Permit has no time limit.

Signed: * Mark Stutts Installed by: Bill Shaw

Improvement Permit by: Wesley Sparks RS date 10/4/95

Certificate of Completion by: _____ date _____

Existing System Inspection by: AUTHORIZATION TO CONSTRUCT Wesley Sparks RS date 10/4/95

Operation Permit by: Wesley Sparks RS. date 3/26/96

HEALTH DEPT. COPY: WHITE INSPECTION COPY (FINAL): GREEN OWNER COPY (FINAL): YELLOW INSPECTION COPY (INITIAL): PINK OWNER COPY (INITIAL): GOLD