4648131741

IREDELL COUNTY HEALTH DEPARTMENT

STATESVILLE 704-878-5305 MOORESVILLE 704-664-5281

IMPROVEMENT PERMIT / CERTIFICATE OF COMPLETION / OPERATION PERMIT / EXISTING SYSTEM INSPECTION

PROPERTY DESCRIPTION NO. 18445 DATE Nov 4, 1994 TAX MAP NO. 2P6A44 Watershed: ☑ Yes ☐ No

OWNER OR CONTRACTOR Clyde L. Brown Jr. PHONE: Business _____ Home (910) 838-4947 LN WSIV

ADDRESS 304 Gordon Rd N. Wilkesboro 28659

LOCATION 150W x I77 TR Bluefield TL Big Indian Loop to water Bear Rt. ~ ½ mile on left

SUBDIVISION Crescent LN BLOCK / SECTION 12 LOT 44 LOT AREA EXISTING SITE CLASS 5 pre 1952 DESIGN FLOW 360 gpd L.T.A.R. .3

Septic Tank: Existing Gallons; STB _____ Date _____

Pump Tank: _____ Gallons; PT _____ Date _____

Pump Make: _____ Model _____ Serial No. _____

Nitrification Field: No Fields 1+EX Square Feet _____ Linear Feet 100'+

No Lines 3 Trench Width 24" Max Trench Bottom Depth ~30" Gravel Depth NA

☐ New System ☐ Repair System Type: I, II, III, IV, V, VI

System Description: grav. PPBPS + EX.

Repair System Description: 4 PPBPS

Maintenance Agreement Required: ☐ Yes ☑ No

☑ House/Mod. Home No. Bedrooms 3

☐ Mobile Home No. Bathrooms 3

☐ Business No. Employees _____

☐ Other _____


☐ Slab ☑ Crawl Space ☐ Basement w/plumbing ☐ Basement wo/plumbing

Water Supply: ☐ Individual ☐ Community ☐ Public


Comments: Upgrading from 2 bedroom to 3 bedroom capacity. 3

Comments: (Addition)

INITIAL SITE SKETCH

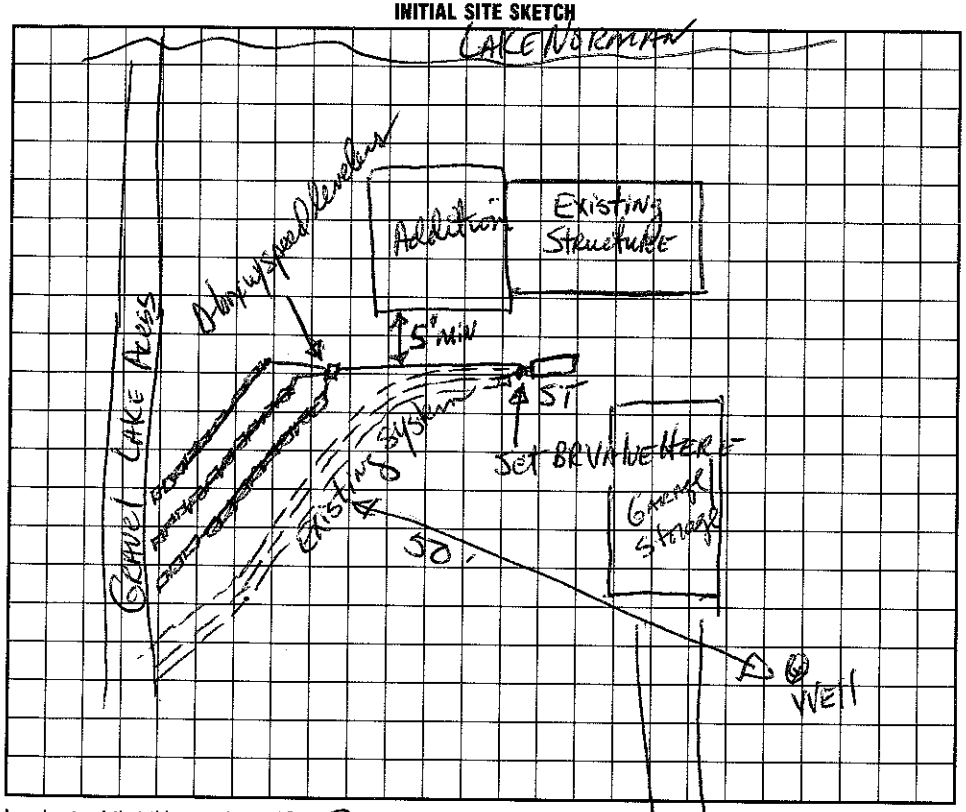

AS BUILT SKETCH

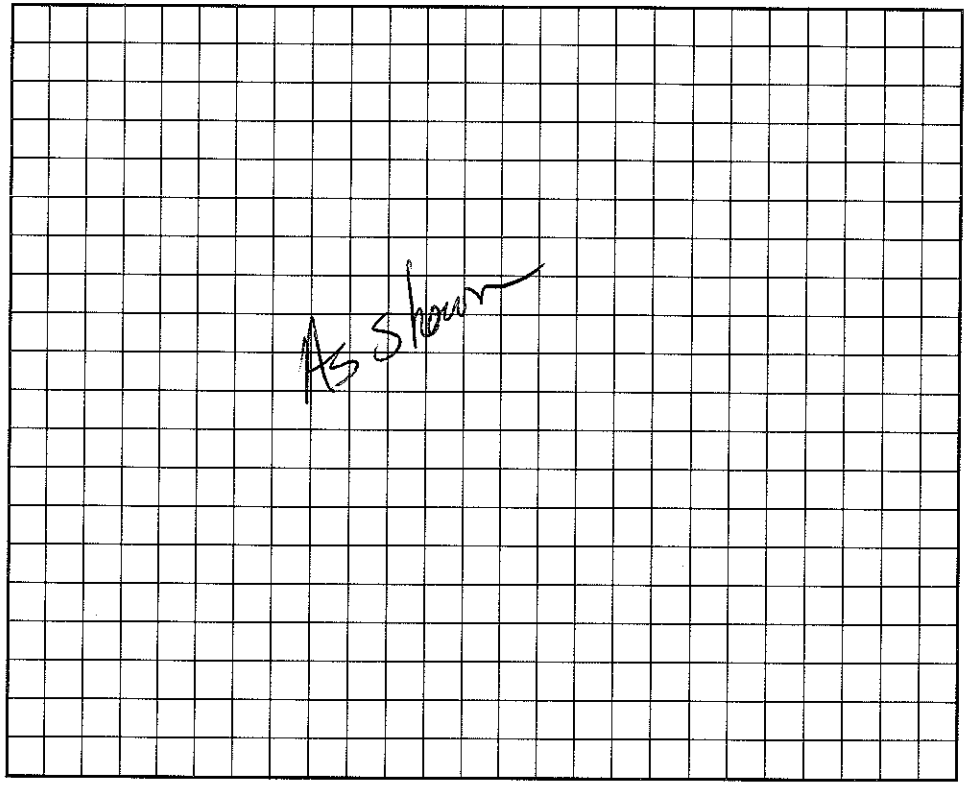

I understand that this permit can be suspended or revoked if any false information is supplied toward securing the permit/any unauthorized changes are made to the site/any unauthorized changes are made in the installation of the system. Improvement Permit is valid for 60 months from date of issuance.

Signed: Clyde L. Brown Jr. Big Indian Loop

Improvement Permit by: [signature] IRS date 11/4/94

Existing System Inspection by: _____ date _____

Installed by: J.R. Bowles

Certificate of Completion by: _____ date _____

Operation Permit by: [signature] IRS date 1-1-95

HEALTH DEPT. COPY: WHITE INSPECTION COPY (FINAL): GREEN OWNER COPY (FINAL): YELLOW INSPECTION COPY (INITIAL): PINK OWNER COPY (INITIAL): GOLD