IREDELL COUNTY HEALTH DEPARTMENT

STATESVILLE 704-878-5305 MOORESVILLE 704-664-5281

IMPROVEMENT PERMIT / CERTIFICATE OF COMPLETION / OPERATION PERMIT / EXISTING SYSTEM INSPECTION

PROPERTY DESCRIPTION NO. 21586 DATE 7/23/95 TAX MAP NO. 2P6B43 Watershed: ☐ Yes ☒ No

OWNER OR CONTRACTOR Jimmy Neil Riddle PHONE: ~~Business~~ 648-13-1741 Home 853-3011

ADDRESS 2434 Robelud Dr. Dastonia, NC. 28056

LOCATION 150W Bluefield Rd. TL Big Indian Rp. (R) in the pasture across from Church Dr.

SUBDIVISION Indian Hill BLOCK / SECTION ____ LOT 43 LOT AREA 1.48 AC SITE CLASS. 1RS DESIGN FLOW 360 L.T.A.R. .3

Septic Tank: 1000 Gallons; STB 825 Date 10/7/95

Pump Tank: ____ Gallons; PT ____ Date ____

Pump Make: ____ Model ____ Serial No. ____

Nitrification Field: No. Fields 1 Square Feet 1200 Linear Feet *300 (400)

No Lines 3 X 40 Trench Width 36" Max Trench Bottom Depth 36" Gravel Depth N/R

☒ New System ☐ Repair System Type: I, II, III, IV, V, VI

System Description: Drainfield w/ Infiltrator

Repair System Description: ____

Maintenance Agreement Required: ☐ Yes ☒ No

☒ House/Mod. Home ☐ Mobile Home ☐ Business ☐ Other

No. Bedrooms 3 No. Bathrooms 3 No. Employees ____


☐ Slab ☒ Crawl Space ☐ Basement w/plumbing ☐ Basement wo/plumbing

Water Supply: ☒ Individual ☐ Community ☐ Public


Comments: * 25% reduction for Infiltrator
1/22/96 May use 40' of Conventional drainfield Hes

Comments:

INITIAL SITE SKETCH

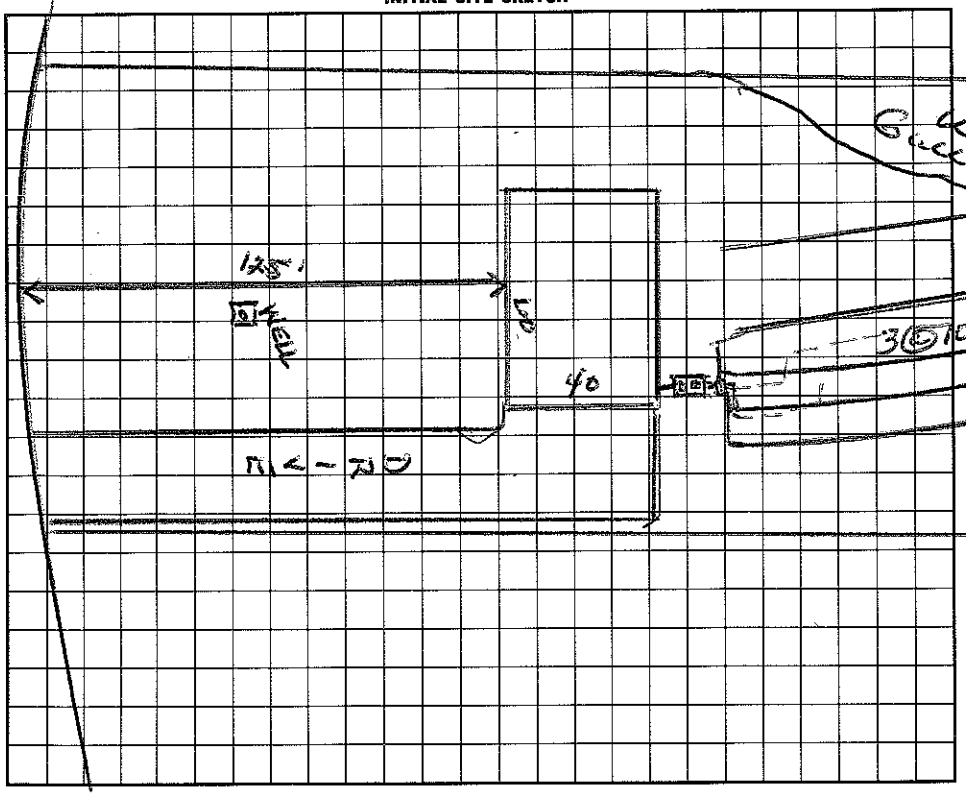

AS BUILT SKETCH

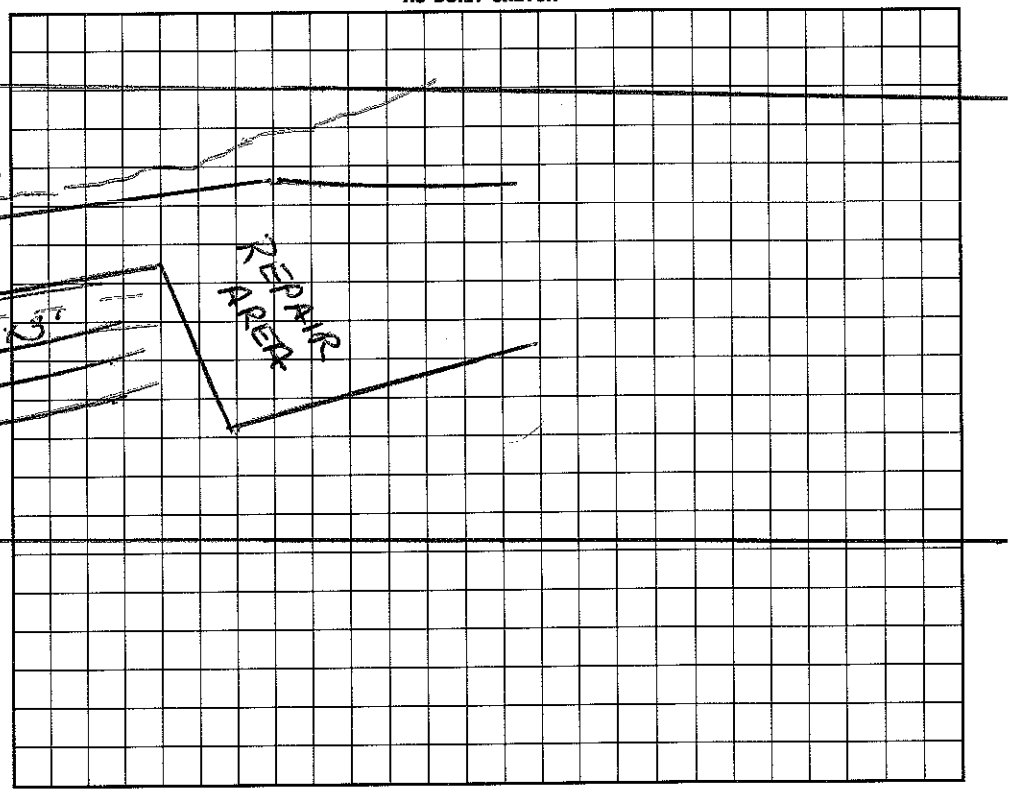

I understand that this permit can be suspended or revoked if any false information is supplied toward securing the permit/any unauthorized changes are made to the site/any unauthorized changes are made in the installation of the system. Improvement Permit is valid for 60 months from date of issuance.

Signed: Neil Riddle

Improvement Permit by: Wesley Sparks R.S. date 7/23/95

Existing System Inspection by: ____ date ____

Installed by: Delbert Bostian

Certificate of Completion by: Wesley Sparks R.S. date 3/21/96

Operation Permit by: Wesley Sparks R.S. date 3/21/96

HEALTH DEPT. COPY: WHITE INSPECTION COPY (FINAL): GREEN OWNER COPY (FINAL): YELLOW INSPECTION COPY (INITIAL): PINK OWNER COPY (INITIAL): GOLD