4648-13-3412

IREDELL COUNTY HEALTH DEPARTMENT

STATESVILLE 704-878-5305 MOORESVILLE 704-664-5281

IMPROVEMENT PERMIT / CERTIFICATE OF COMPLETION / OPERATION PERMIT / EXISTING SYSTEM INSPECTION

PROPERTY DESCRIPTION NO. 20958 DATE 4/24/95 TAX MAP NO. 2P-B-26 Watershed: ☐ Yes ☒ No

OWNER OR CONTRACTOR Herb Wettreich PHONE: Business 664-4488 Home

ADDRESS Rt 4 Box 410 Mooresville NC 28115

LOCATION Big Indian Tp. Bluewing onto Big Indian straight around curve on (R)

SUBDIVISION Indian Forest BLOCK / SECTION U LOT 3 LOT AREA ≈1.07Ac SITE CLASS. P DESIGN FLOW 360 L.T.A.R. .35

Septic Tank: 1000 Gallons; STB 714 Delinga Date 7-10-95

Pump Tank: Gallons; PT Date

Pump Make: Model Serial No.

Nitrification Field: No Fields 1 Square Feet 1028 Linear Feet 380

No Lines 4 Trench Width 36" Max Trench Bottom Depth 30-32" Gravel Depth 12"

☒ New System ☐ Repair System Type: ☒ I ☐ II, III, IV, V, VI

System Description: GRAVITY - CONVENTIONAL

Repair System Description: SAME

Maintenance Agreement Required: ☐ Yes ☒ No

☒ House/Mod. Home No. Bedrooms 3

☐ Mobile Home No. Bathrooms 2

☐ Business No. Employees

☐ Other


☐ Slab ☒ Crawl Space ☐ Basement w/plumbing ☐ Basement wo/plumbing

Water Supply: ☐ Individual ☐ Community ☐ Public


Comments:

Comments:

INITIAL SITE SKETCH

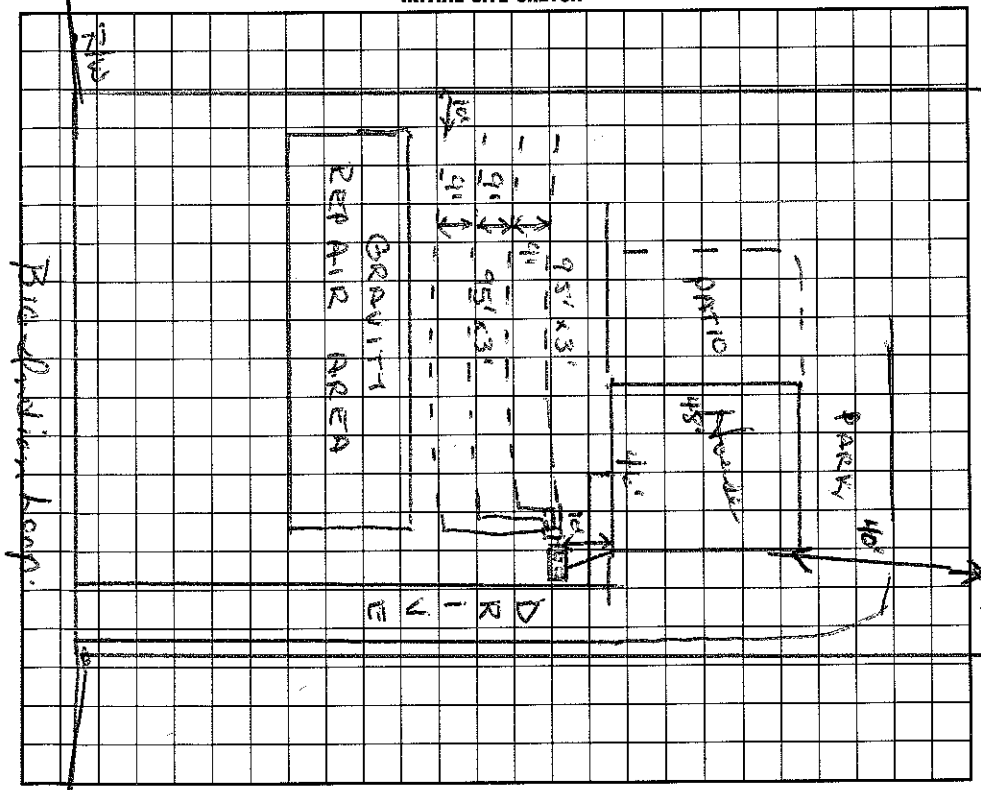

AS BUILT SKETCH

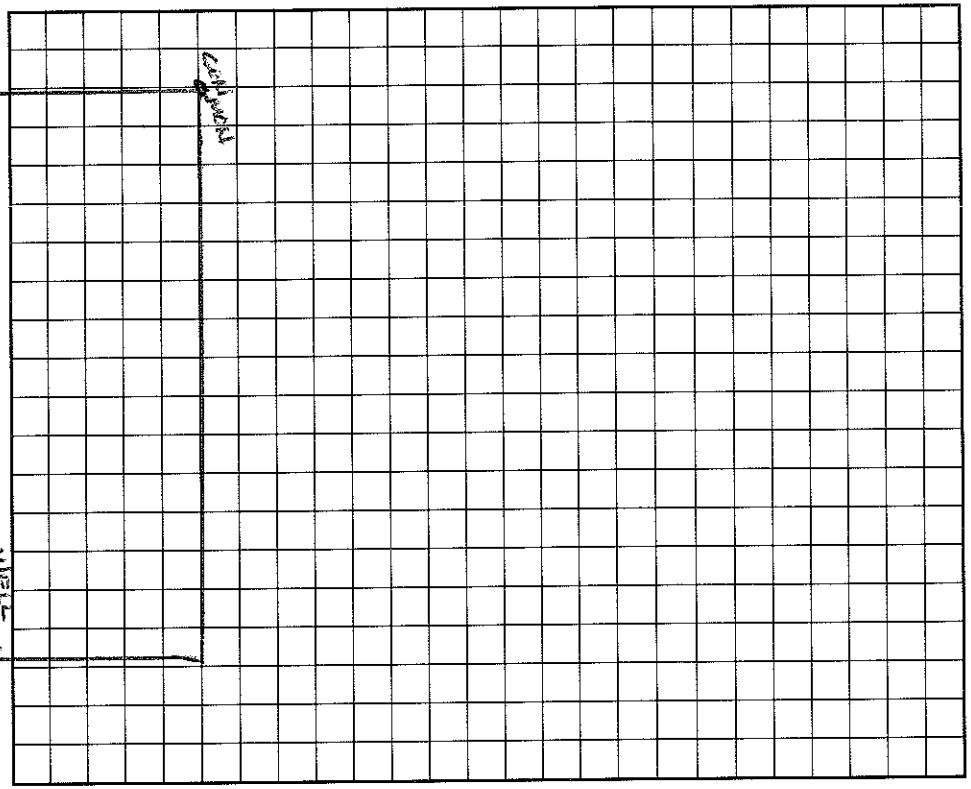

I understand that this permit can be suspended or revoked if any false information is supplied toward securing the permit/any unauthorized changes are made to the site/any unauthorized changes are made in the installation of the system. Improvement Permit is valid for 60 months from date of issuance.

Signed: X Bill Shuler

Improvement Permit by: Wesley Sparks R.S. date 4/25/95

Existing System Inspection by: date

Installed by: Robison

Certificate of Completion by: [illegible] RS date 9-13-95

Operation Permit by: date

HEALTH DEPT. COPY: WHITE INSPECTION COPY (FINAL): GREEN OWNER COPY (FINAL): YELLOW INSPECTION COPY (INITIAL): PINK OWNER COPY (INITIAL): GOLD