IREDELL COUNTY HEALTH DEPARTMENT

Statesville Office (704) 878-5305 Mooresville Office (704) 663-3625 PERMIT # 201641 ~~FR2304~~

IMPROVEMENT PERMIT / AUTHORIZATION TO CONSTRUCT / OPERATION PERMIT / EXISTING SYSTEM

PIN # 4648-13-5720

APPLICANT: MIKE YOUNG APPLICANT ADDRESS: 221 FOURTRAX DR.

SITE ADDRESS: 522 BIG INDIAN LOOP PHONE: 704-363-5571 ALT. PHONE:

SITE DIRECTIONS: BLUEFIELD, BIG INDIAN LOOP

SUBDIVISION: INDIAN FOREST SECTION: LOT # 14 LOT AREA: .88AC DESIGN FLOW: 600 L.T.A.R.: .25

Septic Tank *1500 (gal) STB 1600 Date 5-7-14
Pump Tank EXISTING (gal) PT Date
Pump Make Model Serial #
Nitrification Fields 1 # Lines 1@120' Linear Ft: 120'
Trench Width 36" Max. Trench Bottom Depth 36" Gravel Depth —

☐ New System ☐ Repair ☒ Expansion System Type: I II ☒ IIIB IV V VI
System Description: PM 75% REDUCTION
Repair System Description: LP-PANEL BLOCK
Maintenance Agreement Required: ☐ YES ☒ NO ☐ GRAVITY ☒ PRESSURE


☒ Residence ☐ Business ☐ Other ☐ Slab ☒ Crawl Space ☐ Basement w/plumbing
No. Bedrooms 5 No. Persons 10 No. Employees

Water Supply: ☒ Private ☐ Public ☐ Community ☐ Basement w/o plumbing


Comments / Conditions: KEEP SHED ROOF FOUNDATION 5' FROM TANKS - CSF 2/21/14

New ST taking Sewage from addition only. New drain line has valve outside of Pressure Manifo

INITIAL SITE SKETCH

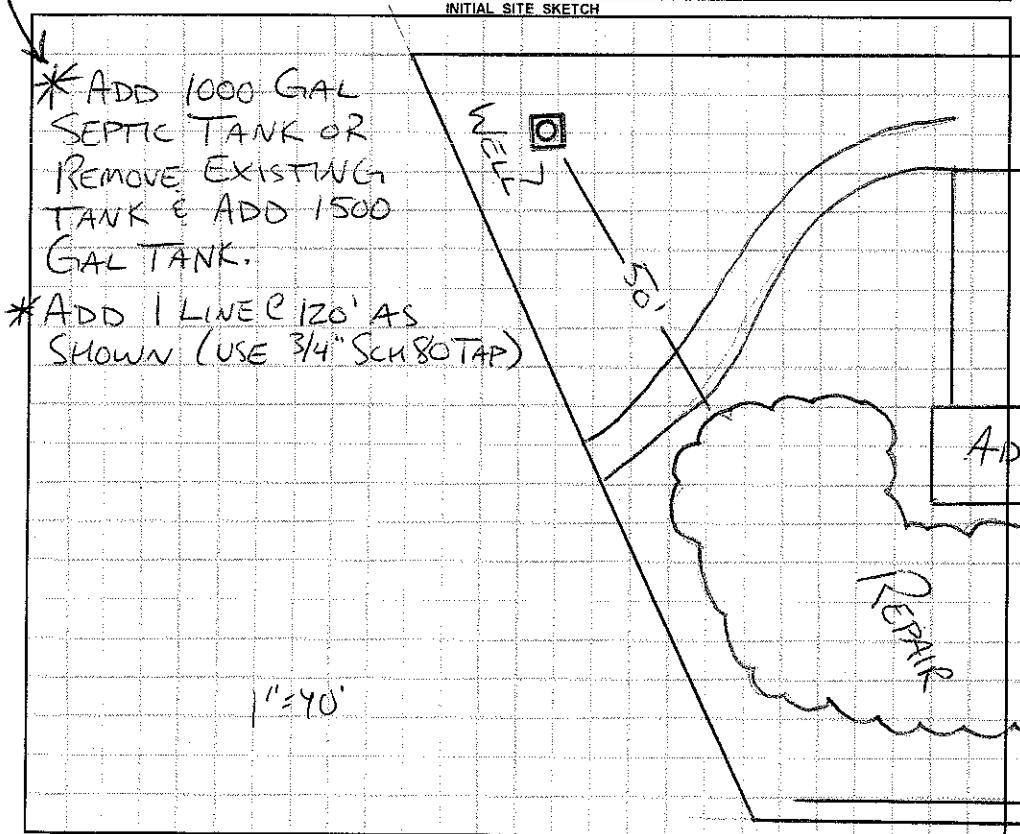

AS BUILT SKETCH

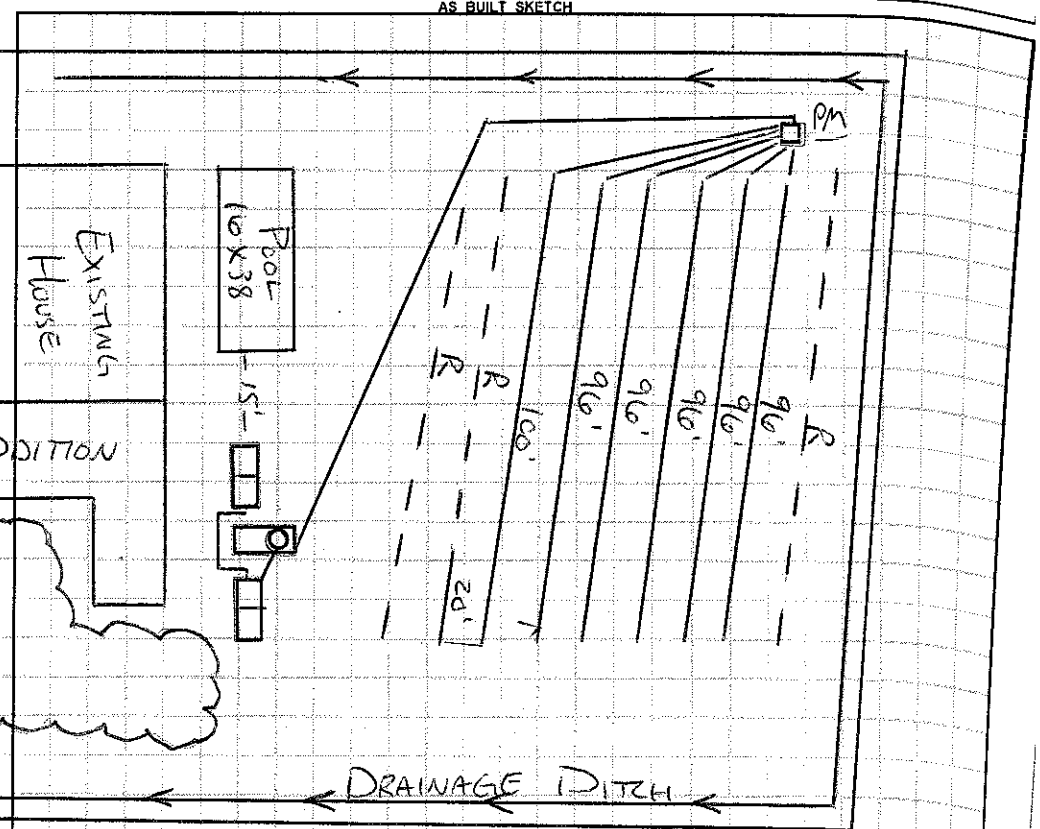

Permit can be suspended or revoked if any false information is supplied toward securing the permit / any unauthorized changes are made to the site / any unauthorized changes are made in the installation of the system. **CONTACT A LOCATOR SERVICE PRIOR TO ANY EXCAVATION**

☐ **IMPROVEMENT PERMIT** *with plat valid without expiration.* ☒ **IMPROVEMENT PERMIT** *with site plan valid for 60 mos.* ☒ **AUTHORIZATION TO CONSTRUCT** *valid for period equal to IMPROVEMENT PERMIT--not to exceed 60 mo.*

Owner / Applicant Signature: Date: 11-19-13 Installed by: K & M Grading RS

IMPROVEMENT PERMIT by: Date: 11-13-1213 mo OPERATION PERMIT by: Date: 7/8/14

AUTHORIZATION TO CONSTRUCT by: Date: 12-9-13 Existing System Inspected by: Date:

Health Dept. Copy - WHITE Applicant (Final Approval) - YELLOW Applicant (Conditional Approval) - PINK