IREDELL COUNTY HEALTH DEPARTMENT

Statesville Office (704) 878-5305 Mooresville Office (704) 660-3625 PERMIT # 20729

IMPROVEMENT PERMIT / AUTHORIZATION TO CONSTRUCT / OPERATION PERMIT / EXISTING SYSTEM

PIN # 4648136470

APPLICANT: GEOFF SAUER APPLICANT ADDRESS: 376 41st AVE PLACE NW HICKORY 28601

SITE ADDRESS: 126 CASTLE DR. MOORESVILLE NC 28117 PHONE: ALT. PHONE: 578-4951

SITE DIRECTIONS: BLUEFIELD - TL BIG INDIAN - TR 1ST BIG INDIAN - TL CASTLE DR LOT ON RT

SUBDIVISION: INDIAN FOREST SECTION: 2 LOT # 18 LOT AREA: 1.1AC DESIGN FLOW: 480GPD L.T.A.R.: .3

Septic Tank	1000 (gal)	STB	825	Date	11-9-14	☑ New System ☐ Repair ☐ Expansion	System Type: I II (III) IV V VI	☐ Residence	No. Bedrooms 4
Pump Tank	(gal)	PT		Date		System Description:	GRAVITY 25% REDUCTION	☐ Business	No. Persons 8
Pump Make		Model		Serial #		Repair System Description:	LSAPPS	☐ Other	No. Employees
# Nitrification Fields	1	# Lines	6	Linear Ft:	405	Maintenance Agreement Required:	☐ YES ☑ NO	☐ Slab	☑ Crawl Space
Trench Width	36"	Max. Trench Bottom Depth	30"	Gravel Depth	N/A		☑ GRAVITY ☐ PRESSURE	☐ Basement w/plumbing	☐ Basement w/o plumbing


Water Supply: ☑ Private ☐ Public ☐ Community

Comments / Conditions:

INITIAL SITE SKETCH

SEE KATHLEEN SAUNDER'S LSS PLAN.

AS BUILT SKETCH

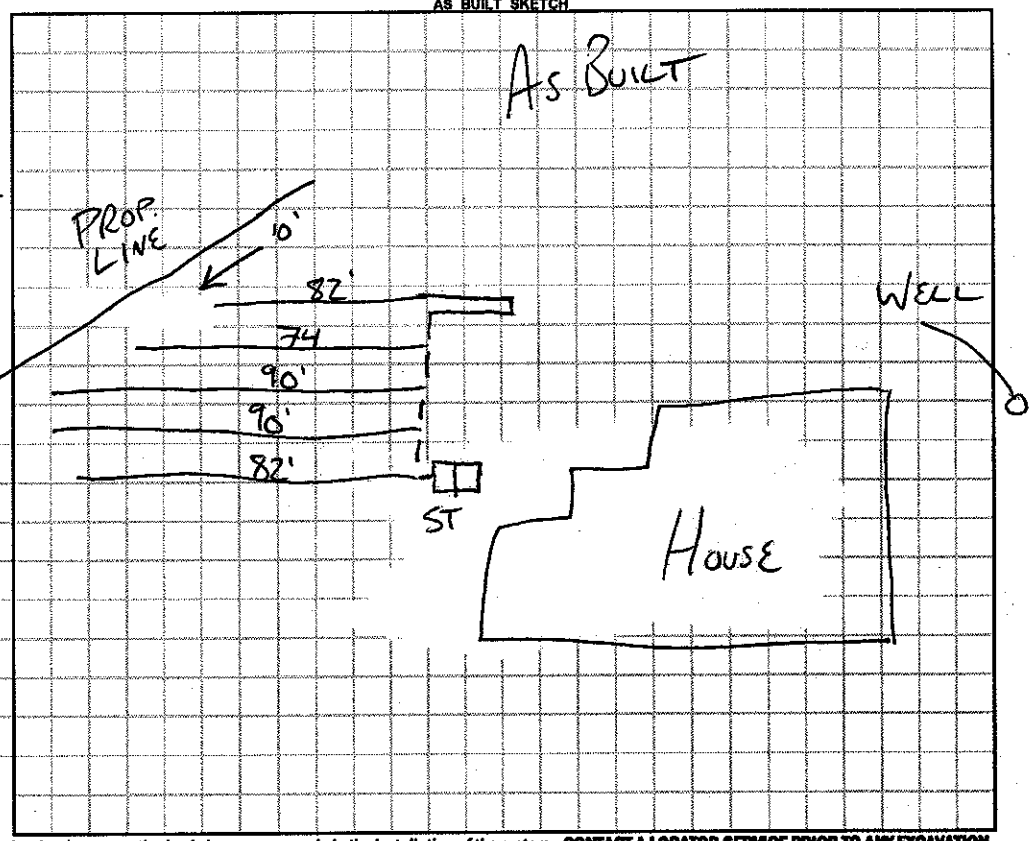

Permit can be suspended or revoked if any false information is supplied toward securing the permit / any unauthorized changes are made to the site / any unauthorized changes are made in the installation of the system. **CONTACT A LOCATOR SERVICE PRIOR TO ANY EXCAVATION**

☐ **IMPROVEMENT PERMIT** *with plat valid without expiration.* ☑ **IMPROVEMENT PERMIT** *with site plan valid for 60 mos.* ☑ **AUTHORIZATION TO CONSTRUCT** *valid for period equal to IMPROVEMENT PERMIT--not to exceed 60 mo.*

Owner / Applicant Signature: Kathleen Saunders Date: 2-24-14 Installed by: Joe Thompson


IMPROVEMENT PERMIT by: [signature] Date: 2/24/14 OPERATION PERMIT by: [signature] Date: APPROVED FEB 12 2015

AUTHORIZATION TO CONSTRUCT by: [signature] Date: 08/29/14 Existing System Inspected by: Date:

Health Dept. Copy - WHITE Applicant (Final Approval) - YELLOW Applicant (Conditional Approval) - PINK

CONNECTGIS WEB HOSTING IREDELL COUNTY NORTH CAROLINA

1:50 Feet

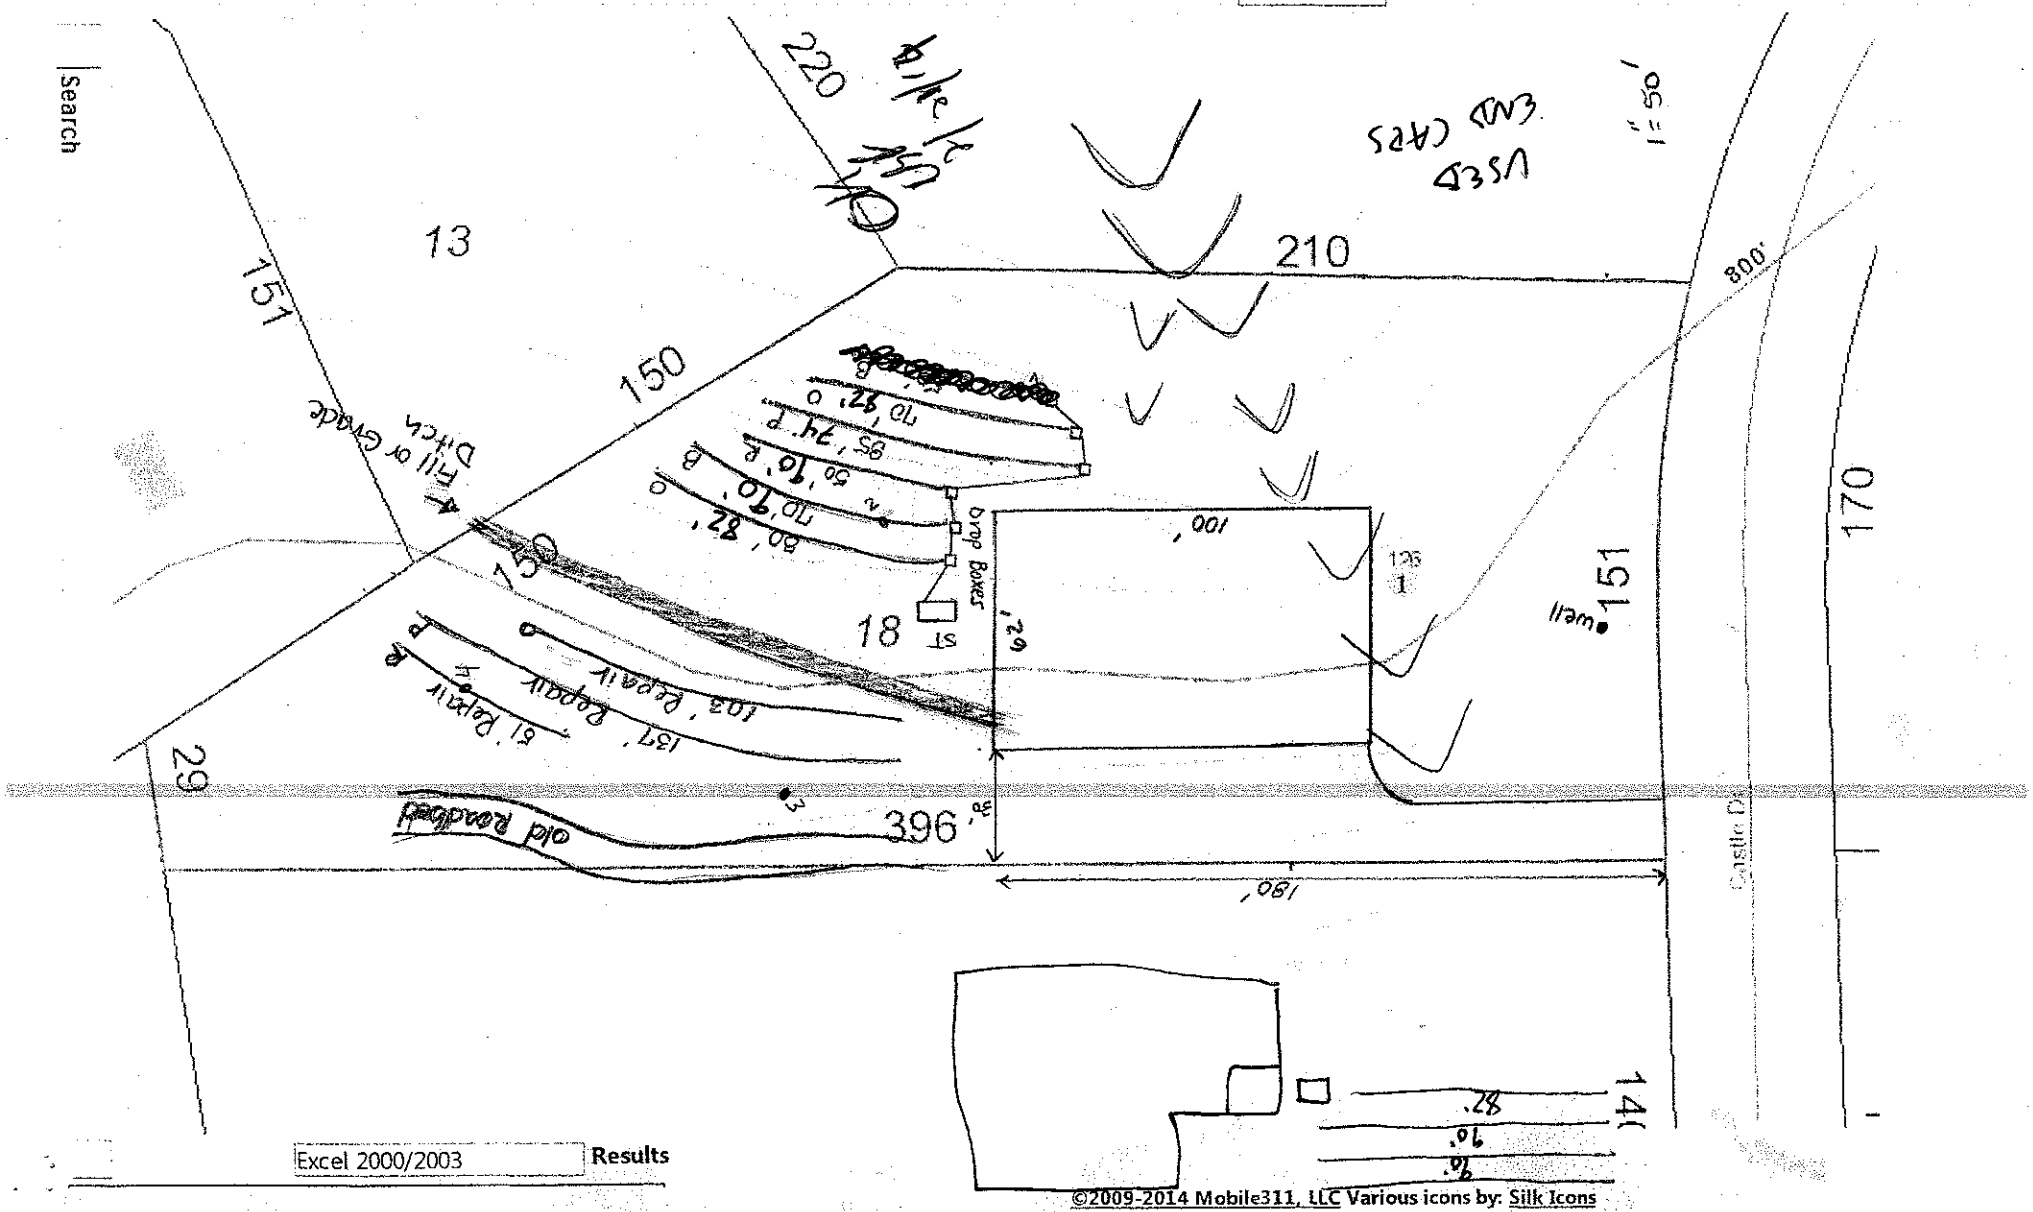

Excel 2000/2003 Results

©2009-2014 Mobile311, LLC Various icons by: Silk Icons