Rep: 3:30pm

IREDELL COUNTY HEALTH DEPARTMENT

STATESVILLE 704-878-5305 MOORESVILLE 704-664-5281

IMPROVEMENT PERMIT / AUTHORIZATION TO CONSTRUCT / OPERATION PERMIT / EXISTING SYSTEM INSPECTION

PERMIT# 12472 PIN# 4648-17-2951 DATE Feb-12-08

OWNER OR APPLICANT Terry Tate PHONE: Business Home 704-660-7819

ADDRESS 838 Cornelius Rd Mooresville, NC 28117

LOCATION Same As owner

SUBDIVISION — BLOCK / SECTION — LOT — LOT AREA 2.86 Ac SITE CLASS. PS DESIGN FLOW 360 L.T.A.R. .4

Septic Tank: existing Gallons: STB Date

Pump Tank: 1 Gallons: PT Date

Pump Make: Model Serial No.

Nitrification Field: No Fields Square Feet 510 Linear Feet 170'

No Lines 2@85' Trench Width 36 Max Trench Bottom Depth 36 Gravel Depth

☐ New System ☒ Repair ☐ Expansion System Type: I II (III) IV V VI

System Description: Gravity 25% Red

Repair System Description: Gravity 25% Red

Maintenance Agreement Required: ☐ Yes ☒ No

☒ House/Mod. Home ☐ Mobile Home ☐ Business ☐ Other

No. Bedrooms 3 No. Persons No. Employees

Water Supply: ☒ Individual ☐ Public ☐ Community


☒ Gravity ☐ Pressure ☐ Slab ☒ Crawl Space ☐ Basement w/plumbing ☐ Basement wo/plumbing

Comments:/Conditions: Install 2 new lines, starting 10' below pool deck (2@85') on contour/Install new distribution box with at least 5 outlets/Use speed levelers to take pressure off of


Comments:/Conditions: Failing lines / Make sure drains from house do not run over septic system

* 1"=60'

INITIAL SITE SKETCH

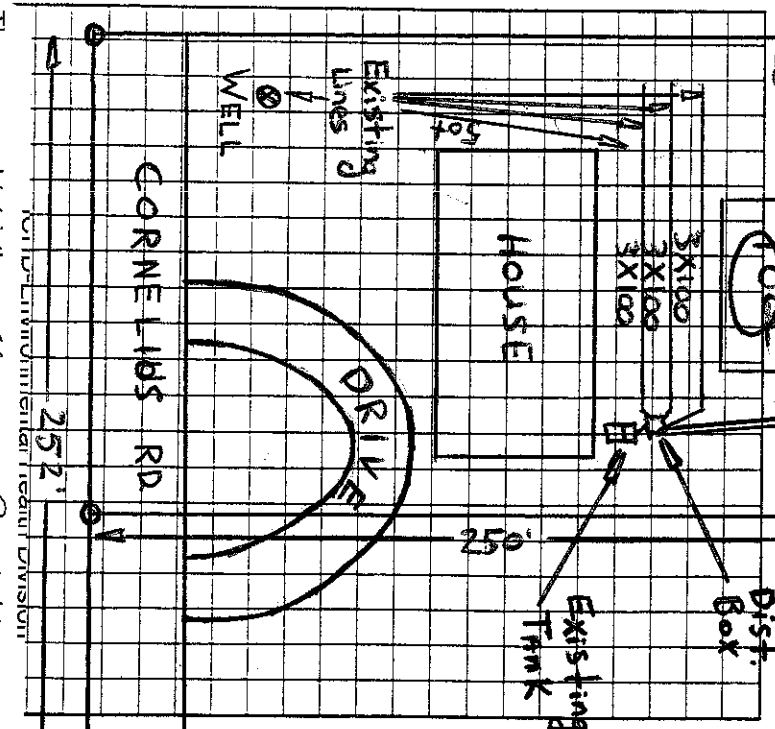

AS BUILT SKETCH

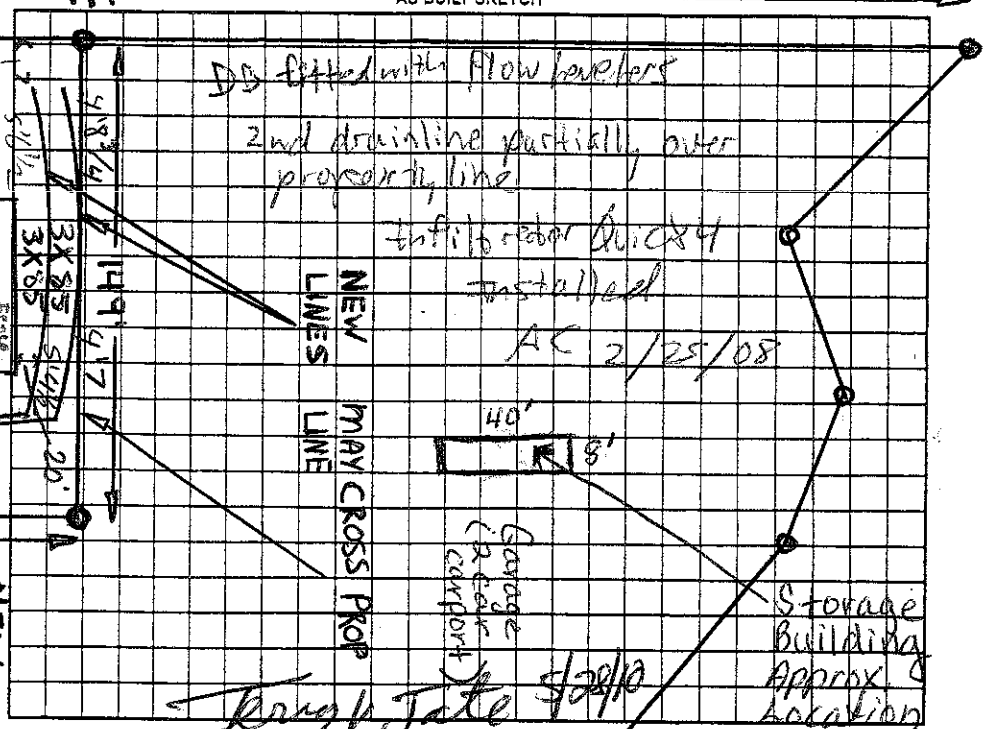

The proposed / existing Storage Building addition does not appear to impact the existing septic system.

**NOTE:

Date: 2-28-10

Jerry Mehaffey REHS

ICHD-Environmental Health Division

Terry Tate 2/28/10

ded or revoked if any false information is supplied toward securing the permit/any unauthorized changes are made to the site/any unauthorized changes are made in the installation of the system. Improvement

Permit with initial valid without expiration ☐ Improvement Permit with site plan valid for sixty months ☒ Authorization to Construct is valid for a period equal to that of Improvement Permit – not to exceed sixty months.

Signed: Karen Tate date

Installed by: Wayne Clontz

Improvement Permit by: RSI date Feb-12-08

Authorization to Construct by: RSI date Feb-12-08

Operation Permit by: Anthony Coker II date 2/25/08

Existing System Inspection by: date

HEALTH DEPT. COPY: WHITE OWNER COPY (FINAL): YELLOW OWNER COPY (INITIAL): PINK