4648173403

IREDELL COUNTY HEALTH DEPARTMENT

STATESVILLE 704-878-5305 MOORESVILLE 704-664-5281

IMPROVEMENT PERMIT / CERTIFICATE OF COMPLETION / OPERATION PERMIT / EXISTING SYSTEM INSPECTION

PROPERTY DESCRIPTION NO. 19555 DATE 10/14/94 TAX MAP NO. 25 A 38 Pt of. Watershed: ☐ Yes ☑ No

OWNER OR CONTRACTOR Michael Lynn Mills PHONE: Business _____ Home 664-5033

ADDRESS 160 Shepard Rd. Mooresville, NC. 28115

LOCATION Cornelius Rd., South Rd. to Cornelius Rd. ~.8 mile on (R) just past Morgan Ln.

SUBDIVISION N/A BLOCK / SECTION _____ LOT N/A LOT AREA ~1.4 Ac. SITE CLASS. P DESIGN FLOW 360' L.T.A.R. .25

Septic Tank: 1000 Gallons; STB 794 Date 4-18-95

Pump Tank: _____ Gallons; PT _____ Date _____

Pump Make: _____ Model _____ Serial No. _____

Nitrification Field: No Fields 1 Square Feet 1440 Linear Feet 480

No Lines 4 @ 5 Trench Width 36" Max Trench Bottom Depth 30" Gravel Depth 12"

☑ New System ☐ Repair System Type: I (II) III, IV, V, VI

System Description: DIST BOX - CONVENTIONAL

Repair System Description: _____

Maintenance Agreement Required: ☐ Yes ☑ No

☑ House/Mod. Home No. Bedrooms 3

☐ Mobile Home No. Bathrooms 2

☐ Business No. Employees _____

☐ Other _____


☐ Slab ☐ Crawl Space ☑ Basement w/plumbing ☐ Basement wo/plumbing

Water Supply: ☑ Individual ☐ Community ☐ Public

Comments: 5 @ 95' x 3' 6/2/95 Mills

Comments: 95 / 3 / 475

INITIAL SITE SKETCH

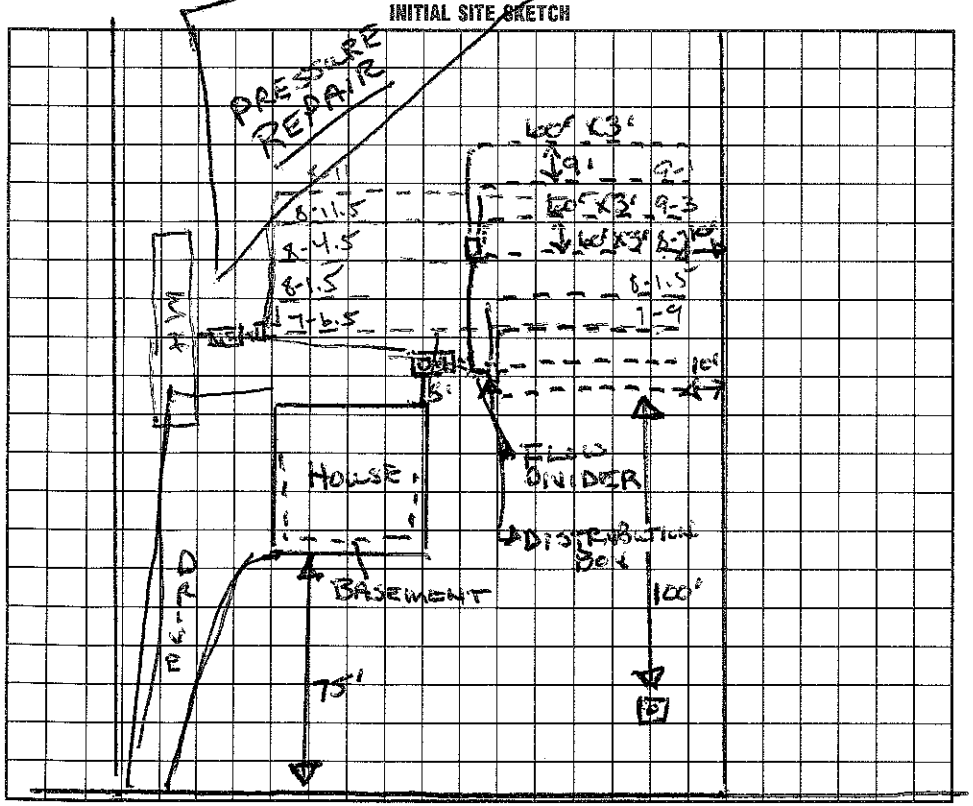

AS BUILT SKETCH

Installed as shown.

I understand that this permit can be suspended or revoked if any false information is supplied toward securing the permit/any unauthorized changes are made to the site/any unauthorized changes are made in the installation of the system. Improvement Permit is valid for 60 months from date of issuance. CORNELIUS RD.

Signed: Michael L. Mills

Improvement Permit by: Wesley Sparks RS. date 10/14/94

Existing System Inspection by: _____ date _____

Installed by: Dennis Belcher

Certificate of Completion by: Wesley Sparks RS. date 6/1

Operation Permit by: _____ date _____

HEALTH DEPT. COPY: WHITE INSPECTION COPY (FINAL): GREEN OWNER COPY (FINAL): YELLOW INSPECTION COPY (INITIAL): PINK OWNER COPY (INITIAL): GOLD