IREDELL COUNTY HEALTH DEPARTMENT

STATESVILLE 704-878-5305 MOORESVILLE 704-664-5281

IMPROVEMENT PERMIT / CERTIFICATE OF COMPLETION / OPERATION PERMIT / EXISTING SYSTEM INSPECTION

PROPERTY DESCRIPTION NO. 16394 DATE 8/27/93 TAX MAP NO. 25-7-A-30

OWNER OR CONTRACTOR SPEAR CONST. INC. PHONE: Business 636-7954 Home 4648 17 5875

ADDRESS 607 ANDERSON AVE. SALISBURY, NC. 28144

LOCATION CORNELIUS RD, TR. LOT ON (E) CORNER

SUBDIVISION MILLS FOREST BLOCK / SECTION — LOT 30 LOT AREA 30 SITE CLASS. P L.T.A.R. 0.3

Water Supply: ☑ Individual ☐ Community ☐ Public

Septic Tank: 1000 Gallons; STB 825 Date 8/22/93

Pump Tank: 1000 Gallons; PT 47 Date 8/20/93

Nitrification Field: No Fields 1 Square Feet 1200 Linear Feet 400

No Lines 4 Trench Width 3' Trench Depth 3' Gravel Depth 12"

☑ New System ☐ Repair System Type: I, II, ⓪ IV, V, VI

System Description: PRES-CONV.

Repair System Description: PRES-CONV.

Maintenance Agreement Required: ☐ Yes ☑ No SYR.

☑ House/Mod. Home No. Bedrooms 3 Garbage Disposal: ☐ Yes ☑ No

☐ Mobile Home No. Bathrooms 2 Auto. Dishwasher: ☑ Yes ☐ No


☐ Business No. Employees ____ Auto. Washing Machine: ☑ Yes ☐ No

☐ Other ____ Other ____


☐ Slab ☑ Crawl Space ☐ Basement w/plumbing ☐ Basement wo/plumbing

Comments 1000 GAL. S/T 1000 GAL P/T INSTALLED AS SHOWN
HOUSE TO BE CONSTRUCTED AS SHOWN HERE. USE WASHER BOX AND DIST. BOX AS SHOWN HERE.
11/16/93 CAN GO 4@100'x3' - PRESSURE MANIFOLD MAY BE USE.

INITIAL SITE SKETCH

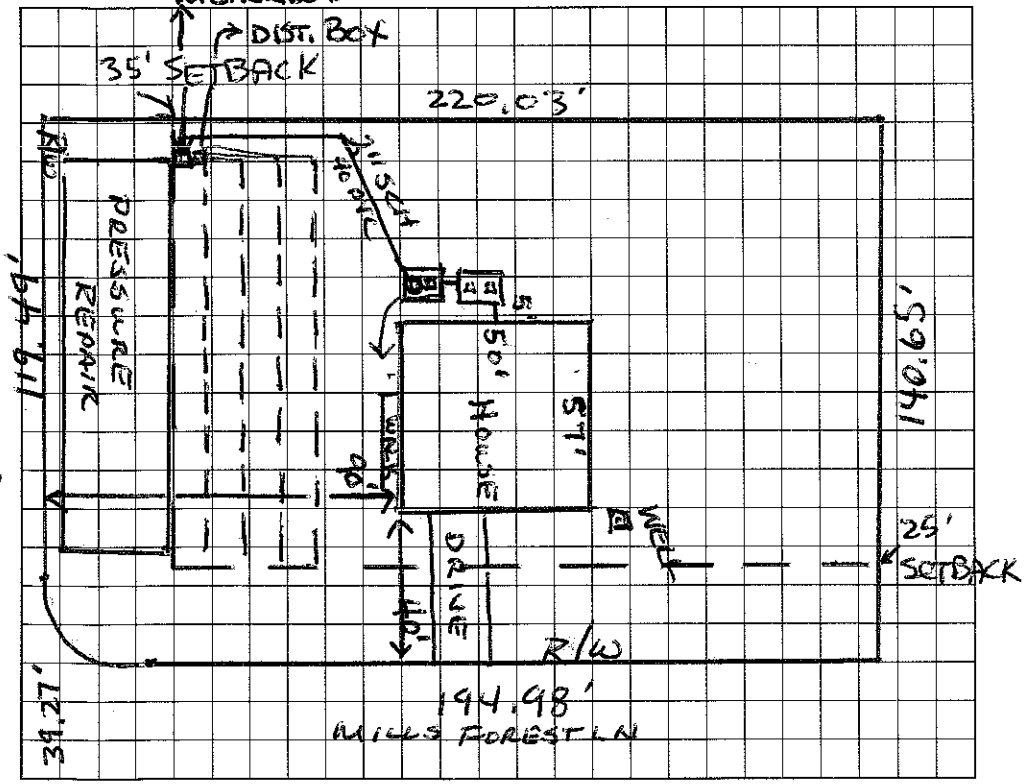

AS BUILT SKETCH

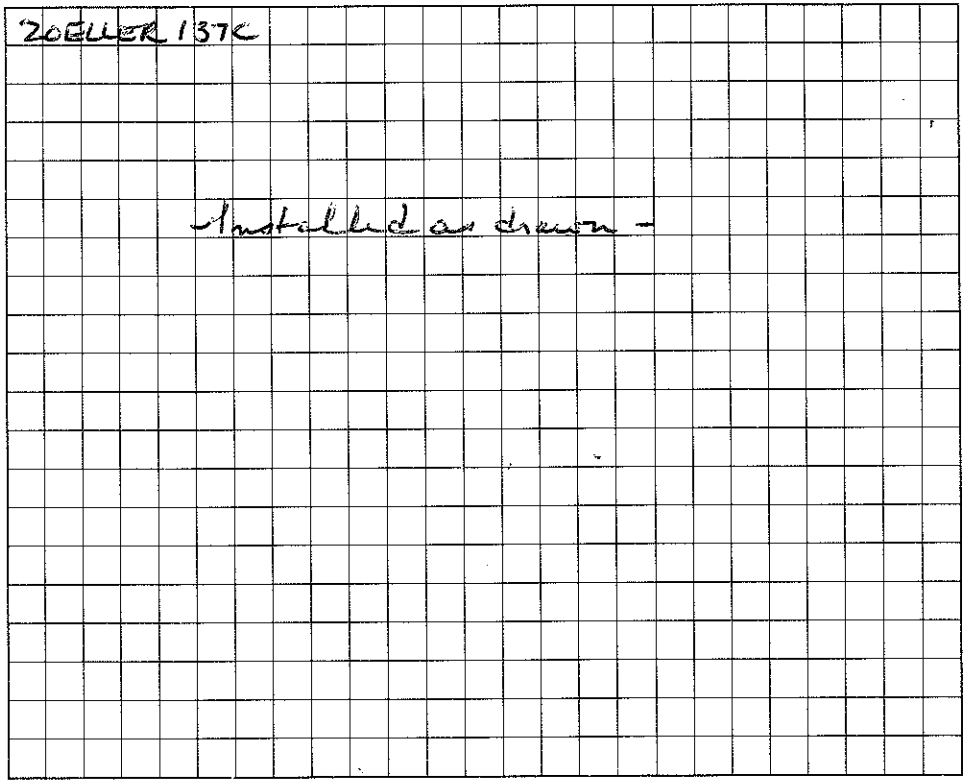

I understand that this permit can be suspended or revoked if any false information is supplied toward securing the permit/any unauthorized changes are made to the site/any unauthorized changes are made in the installation of the system. Improvement Permit is valid for 60 months from date of issuance.

Signed: [signature]

Improvement Permit by: Wesley Sparks R.S. date 8/27/93

Existing System Inspection by: ____ date ____

Installed by: Rowan Septic Tech

Certificate of Completion by: Wesley Sparks R.S. date 11/19/93

Operation Permit by: ____ date ____

HEALTH DEPT. COPY: WHITE INSPECTION COPY (FINAL): GREEN OWNER COPY (FINAL): YELLOW INSPECTION COPY (INITIAL): PINK OWNER COPY (INITIAL): GOLD