# IREDELL COUNTY HEALTH DEPARTMENT

STATESVILLE 704-878-5305 MOORESVILLE 704-664-5281

## IMPROVEMENT PERMIT / CERTIFICATE OF COMPLETION / OPERATION PERMIT / EXISTING SYSTEM INSPECTION

PROPERTY DESCRIPTION NO. 16215 DATE 10/26/93 TAX MAP NO. 25 7 A 22 Watershed: ☑ Yes ☐ No

OWNER OR CONTRACTOR SPEARS CONSTRUCTION PHONE: Business 636-7954 Home

ADDRESS 607 ANDERSON AVE SALISBURY, NC. 28144 4648-18-0402

LOCATION MILLS FOREST LN, ON (C) BEFORE LAST STREET TO (R)

SUBDIVISION MILLS FOREST BLOCK / SECTION 1 LOT 22 LOT AREA ~.46AC SITE CLASS. P DESIGN FLOW 240 L.T.A.R. .3 Aws

Septic Tank: 1000 Gallons; STB 625 Date 11/3/93

Pump Tank: Gallons; PT Date

Pump Make: Model Serial No. 466

Nitrification Field: No Fields 1 Square Feet ~~1200~~ 1260 Linear Feet ~~400~~ 420

No Lines Aws 3 & 4 Trench Width 3' Max Trench Bottom Depth 24"-28" Gravel Depth 12"

☑ New System ☐ Repair System Type: I, (II), III, IV, V, VI

System Description: CONV - DIST BOX

Repair System Description: PANEL

Maintenance Agreement Required: ☐ Yes ☐ No

☑ House/Mod. Home No. Bedrooms ~~3~~ 3 Aws

☐ Mobile Home No. Bathrooms 2

☐ Business No. Employees

☐ Other


☐ Slab ☑ Crawl Space ☐ Basement w/plumbing ☐ Basement wo/plumbing

Water Supply: ☑ Individual ☐ Community ☐ Public

Comments: WELL MUST BE 25' FROM BLDG. FOUNDATION
ALL WELLS MUST BE 50' MIN. FROM THE CLOSEST
SEPTIC TANK SYSTEM. LINES ON SLOPE CONTOUR
IN DIRECTION SHOWN.

Comments:

**INITIAL SITE SKETCH**

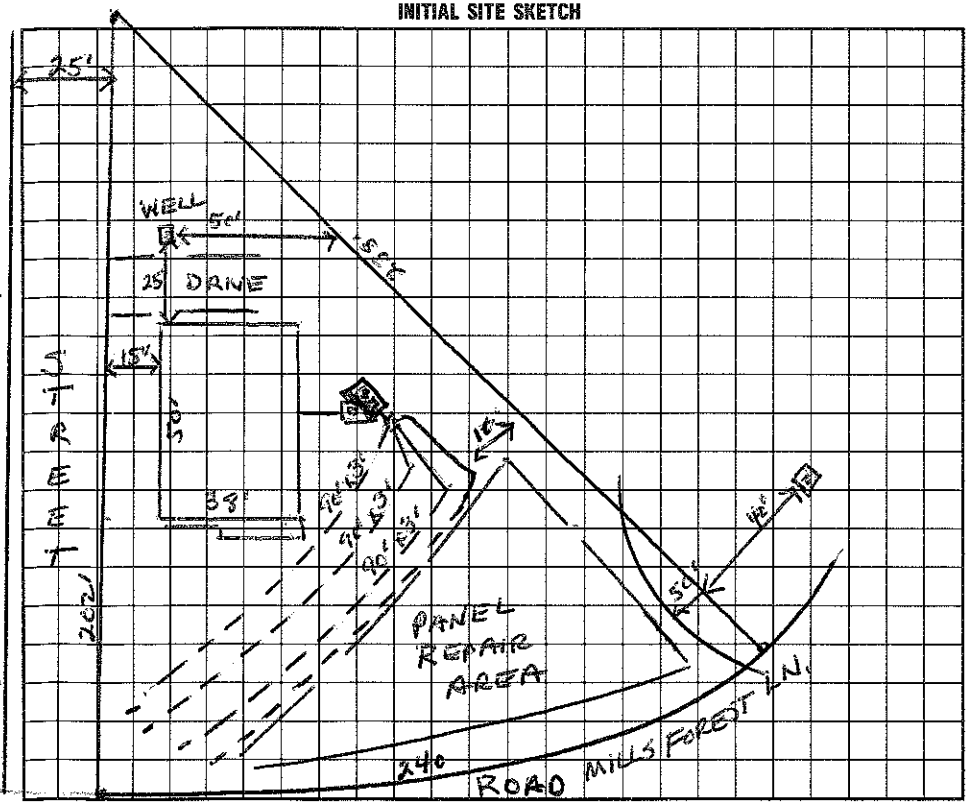


**AS BUILT SKETCH** - Unfilled design Aws

I understand that this permit can be suspended or revoked if any false information is supplied toward securing the permit/any unauthorized changes are made to the site/any unauthorized changes are made in the installation of the system. Improvement Permit is valid for 60 months from date of issuance.

Signed:

Improvement Permit by: Wesley Sparks R.S. date 10/26/93

Existing System Inspection by: date

Installed by: Rowan Septic Tank

Certificate of Completion by: Wesley Sparks R.S. date 1/25/94

Operation Permit by: date

HEALTH DEPT. COPY: WHITE INSPECTION COPY (FINAL): GREEN OWNER COPY (FINAL): YELLOW INSPECTION COPY (INITIAL): PINK OWNER COPY (INITIAL): GOLD