IREDELL COUNTY HEALTH DEPARTMENT

STATESVILLE 704-878-5305 MOORESVILLE 704-664-5281

IMPROVEMENT PERMIT / CERTIFICATE OF COMPLETION / OPERATION PERMIT / EXISTING SYSTEM INSPECTION

PROPERTY DESCRIPTION NO. 16172 DATE 9/29/93 TAX MAP NO. 25-7-A-9

OWNER OR CONTRACTOR SPEAR CONST. CO. PHONE: Business 636-7954 ~~Home~~ 4648-18-2672

ADDRESS CORNELIUS RD MOORESVILLE, NC. 28115

LOCATION CORNELIUS RD. TR TO 2ND LOT ON (R) PAST FIRST CUL DE SAC ON (R)

SUBDIVISION MILLS FOREST BLOCK / SECTION ____ LOT 9 LOT AREA 20700 SQFT² SITE CLASS. P L.T.A.R. .25

Water Supply: ☑ Individual ☐ Community ☐ Public [NOT DRILLED]

Septic Tank: 1000 Gallons; STB 225 Date 10/23/93

Pump Tank: ____ Gallons; PT ____ Date ____

Nitrification Field: No Fields 1 Square Feet 1440 Linear Feet 440

No Lines 4 Trench Width 3' Trench Depth 2' Gravel Depth 12"

☑ New System ☐ Repair System Type: I, (II), III, IV, V, VI

System Description: CONV.

Repair System Description: CONV.

Maintenance Agreement Required: ☐ Yes ☑ No

☑ House/Mod. Home ☐ Mobile Home ☐ Business ☐ Other

No. Bedrooms 3 No. Bathrooms 2 No. Employees ____

☐ Slab ☑ Crawl Space ☐ Basement w/plumbing ☐ Basement wo/plumbing

Garbage Disposal: ☐ Yes ☑ No


Auto. Dishwasher: ☑ Yes ☐ No

Auto. Washing Machine: ☑ Yes ☐ No

Other ____

Comments DO NOT INSTALL DURING WET SOIL CONDITIONS OR RAIN. MAXIMUM TRENCH DEPTH 24". INSTALL ON SLOPE CONTOUR

INITIAL SITE SKETCH

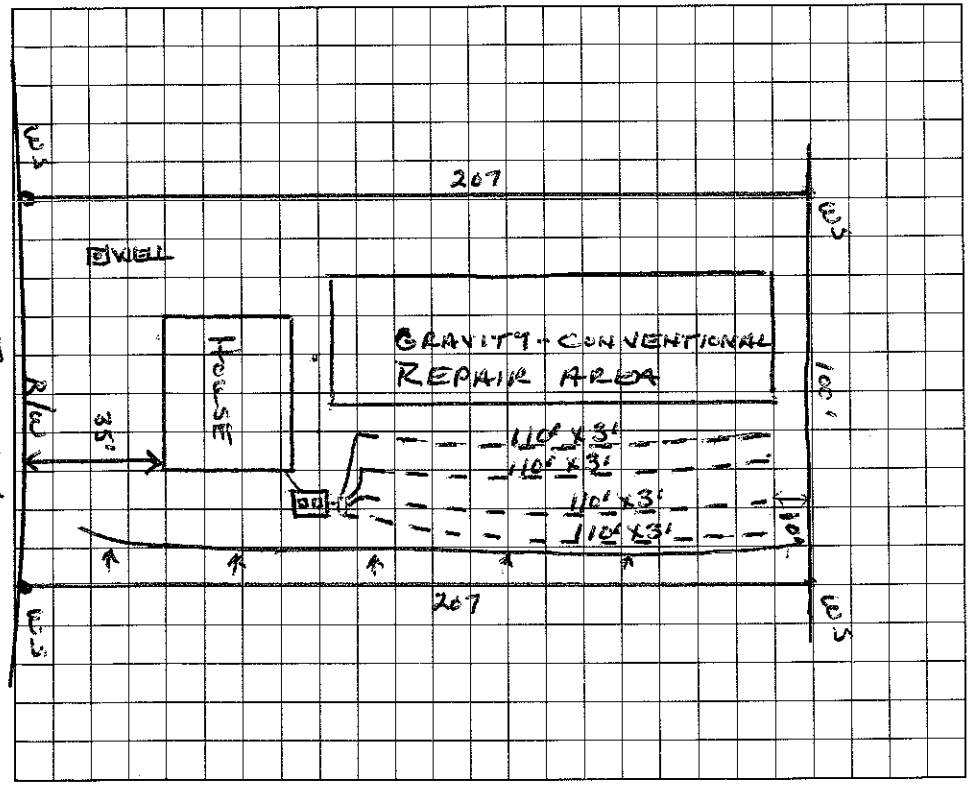

AS BUILT SKETCH

I understand that this permit can be suspended or revoked if any false information is supplied toward securing the permit/any unauthorized changes are made to the site/any unauthorized changes are made in the installation of the system. Improvement Permit is valid for 60 months from date of issuance.

Signed: ____

Improvement Permit by: Wesley Sparks R.S. date 10/1/93

Existing System Inspection by: ____ date ____

Installed by: Rawan Septic Tank

Certificate of Completion by: Wesley Sparks R.S. date 12/8/93

Operation Permit by: ____ date ____

HEALTH DEPT. COPY: WHITE INSPECTION COPY (FINAL): GREEN OWNER COPY (FINAL): YELLOW INSPECTION COPY (INITIAL): PINK OWNER COPY (INITIAL): GOLD