IREDELL COUNTY HEALTH DEPARTMENT
IMPROVEMENT PERMIT / CERTIFICATE OF COMPLETION / OPERATION PERMIT / EXISTING SYSTEM INSPECTION

STATESVILLE 704-878-5305 MOORESVILLE 704-664-5281

PROPERTY DESCRIPTION NO. 17223
OWNER OR CONTRACTOR Krom Financial DATE 3/13/95 TAX MAP NO. 2.5 A 51
ADDRESS 19 Yacht Cove Rd. Mooresville, NC. PHONE: Business 4648-18-2885 Home 664-3671
LOCATION Cowlings Rd, TR into Mills Forest TR on Greentree Rd, R Corner lot on Knospe Ln.
SUBDIVISION Mills Forest BLOCK / SECTION II LOT 1 LOT AREA 0.52 AC SITE CLASS P DESIGN FLOW 360 L.T.A.R. .25-.3

Septic Tank: 1000 Gallons; STB 825 RSI Date 2-14-95
Pump Tank: ____ Gallons; PT ____ Date ____
Pump Make: ____ Model ____ Serial No. ____
Nitrification Field: No Fields 1 Square Feet 1440 Linear Feet * 240
No Lines ____ Trench Width 24" Max Trench Bottom Depth 30" Gravel Depth ____

☑ New System ☐ Repair System Type: I, II, (III), IV, V, VI
System Description: Gravity - PPBS
Repair System Description: Pressure - PPBS 16"
Maintenance Agreement Required: ☑ Yes ☐ No
☐ Slab ☑ Crawl Space ☐ Basement w/plumbing ☐ Basement wo/plumbing


☑ House/Mod. Home ☐ Mobile Home ☐ Business ☐ Other
No. Bedrooms 3 No. Bathrooms 2 No. Employees ____

Water Supply: ☑ Individual ☐ Community ☐ Public

Comments: * .5 reduction for 16" PPBS w/ pressure repair upslope toward rear.
* Additional cover will be required for 6" min. cover

Comments: substantially as shown

INITIAL SITE SKETCH

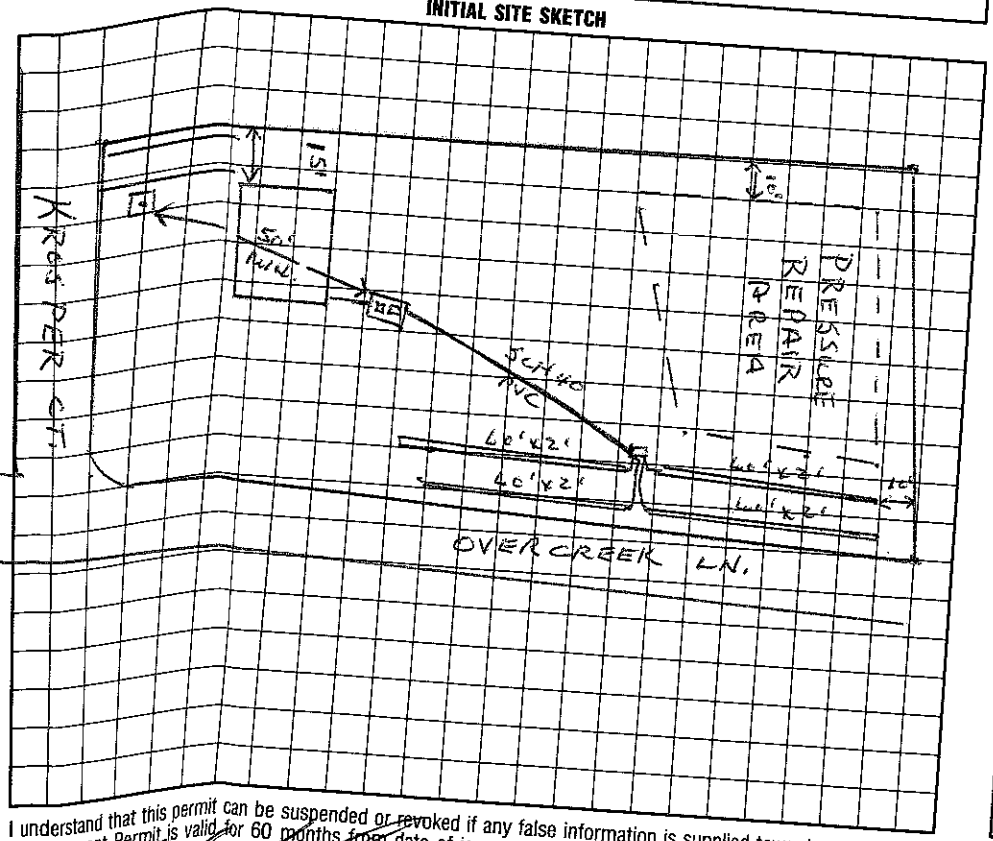

AS BUILT SKETCH

I understand that this permit can be suspended or revoked if any false information is supplied toward securing the permit/any unauthorized changes are made to the site/any unauthorized changes are made in the installation of the system. Improvement Permit is valid for 60 months from date of issuance.

Signed: ____

Improvement Permit by: Wesley Sparks RS date 3/13/95

Existing System Inspection by: ____ date ____

Installed by: Rowan Septic Tank

Certificate of Completion by: ____ date ____

Operation Permit by: ____ date 4/19/95

HEALTH DEPT. COPY: WHITE INSPECTION COPY (FINAL): GREEN OWNER COPY (FINAL): YELLOW INSPECTION COPY