IREDELL COUNTY HEALTH DEPARTMENT

STATESVILLE 704-878-5305 MOORESVILLE 704-664-5281

IMPROVEMENT PERMIT / CERTIFICATE OF COMPLETION / OPERATION PERMIT / EXISTING SYSTEM INSPECTION

PROPERTY DESCRIPTION NO. 16390 DATE july 8 1993 TAX MAP NO. 25-A-7-25

OWNER OR CONTRACTOR Spear Construction Inc. PHONE: Business 704 636 7954 Home

ADDRESS 607 Andreson Avenue Salisbury, NC 28144

LOCATION on north side of Cornelius road, about .4 mile west of Judas road 4648-18-3383

SUBDIVISION Mills Forest BLOCK / SECTION LOT 25 LOT AREA 20,000 sq ft SITE CLASS. P L.T.A.R. 0.3

Water Supply: ☒ Individual ☐ Community ☐ Public

Septic Tank: 1000 Gallons; STB 825 Date 8-5-93

Pump Tank: Gallons; PT Date

Nitrification Field: No Fields 2 Square Feet 1200 Linear Feet 400

No Lines 5 Trench Width Trench Depth Gravel Depth 12"

☒ New System ☐ Repair System Type: I, (II), II, IV, V, VI

System Description: gravity conventional

Repair System Description: grav. panel

Maintenance Agreement Required: ☐ Yes ☒ No

☒ House/Mod. Home No. Bedrooms 3 Garbage Disposal: ☐ Yes ☒ No

☐ Mobile Home No. Bathrooms 2 Auto. Dishwasher: ☒ Yes ☐ No


☐ Business No. Employees Auto. Washing Machine: ☒ Yes ☐ No

☐ Other Other

☐ Slab ☒ Crawl Space ☐ Basement w/plumbing ☐ Basement wo/plumbing

Comments Do not install during wet soil conditions or rain. setback distances to sediment basin; 10' upslope, 15' ~~xx~~ sideslpoe, 25' downslppe. Divert roof runoff away from system

INITIAL SITE SKETCH

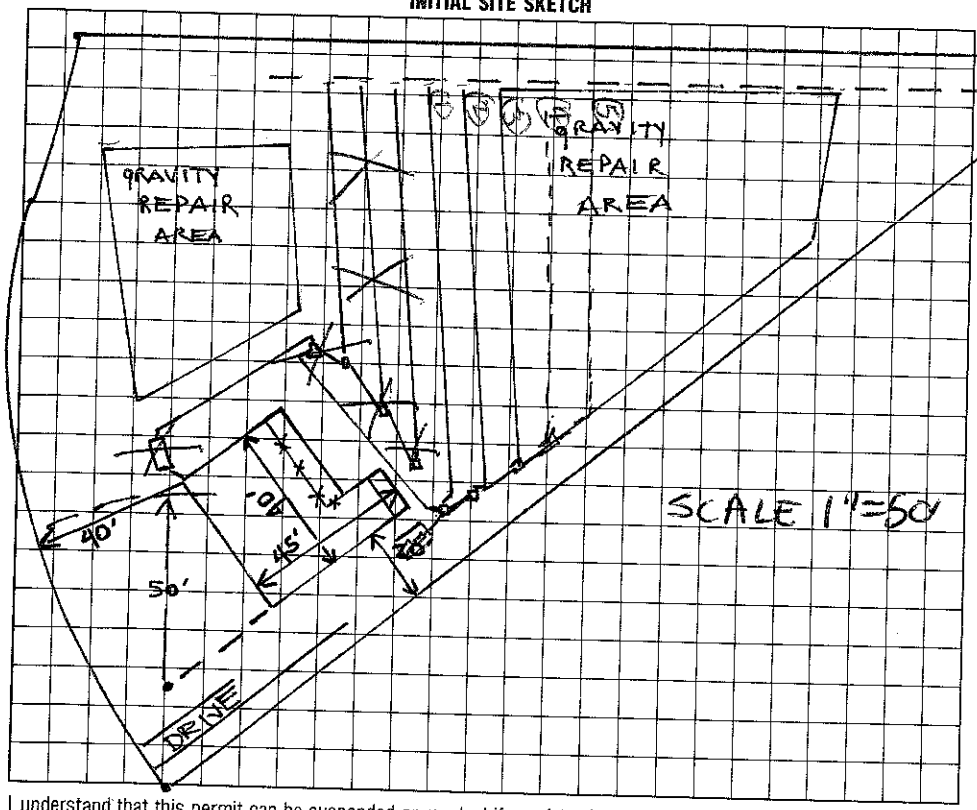

AS BUILT SKETCH

Installed as drawn.

I understand that this permit can be suspended or revoked if any false information is supplied toward securing the permit/any unauthorized changes are made to the site/any unauthorized changes are made in the installation of the system. Improvement Permit is valid for 60 months from date of issuance.

Signed

Improvement Permit by: Andrea Lemon date 7-8-93

Existing System Inspection by: date

Installed by: Rowan Septic Tank

Certificate of Completion by: Wesley Sparks R.S. date 9/23/93

Operation Permit by: date

HEALTH DEPT. COPY: WHITE INSPECTION COPY (FINAL): GREEN OWNER COPY (FINAL): YELLOW INSPECTION COPY (INITIAL): PINK OWNER COPY (INITIAL): GOLD