IREDELL COUNTY HEALTH DEPARTMENT

STATESVILLE 704-878-5305 MOORESVILLE 704-664-5281

IMPROVEMENT PERMIT / CERTIFICATE OF COMPLETION / OPERATION PERMIT / EXISTING SYSTEM INSPECTION

PROPERTY DESCRIPTION NO. 17225 DATE 3/13/95 TAX MAP NO. 25 A 51 Watershed: ☐ Yes ☑ No

OWNER OR CONTRACTOR Krom Financial PHONE: Business 664-3671 ~~Home~~ 4848-18-4894

ADDRESS 19 Yacht Cove Mooresville, NC. 28115

LOCATION Conneline Rd. TR Mill Forest TR Overcreek T.R Krosper To 3rd lot on (R) above intersection

SUBDIVISION Mills Forest N BLOCK / SECTION II LOT 3 LOT AREA n.51AC SITE CLASS. P DESIGN FLOW 360 L.T.A.R. .25

Septic Tank: 1000 Gallons; STB 825 Date 6/11/95

Pump Tank: _____ Gallons; PT _____ Date _____

Pump Make: _____ Model _____ Serial No. _____

Nitrification Field: No Fields 1 Square Feet 1440 Linear Feet 480

No Lines 6 Trench Width 36" Max Trench Bottom Depth 30" Gravel Depth 12"

☑ New System ☐ Repair System Type: I, ☑ II, III, IV, V, VI

System Description: CONV - DROP BOX

Repair System Description: GRAV - PANEL

Maintenance Agreement Required: ☐ Yes ☑ No

☑ House/Mod. Home No. Bedrooms 3

☐ Mobile Home No. Bathrooms 2

☐ Business No. Employees _____

☐ Other _____


☐ Slab ☑ Crawl Space ☐ Basement w/plumbing ☐ Basement wo/plumbing

Water Supply: ☑ Individual ☐ Community ☐ Public


Comments: Additional cover material will be required

Comments: Installed as shown on Approved

INITIAL SITE SKETCH

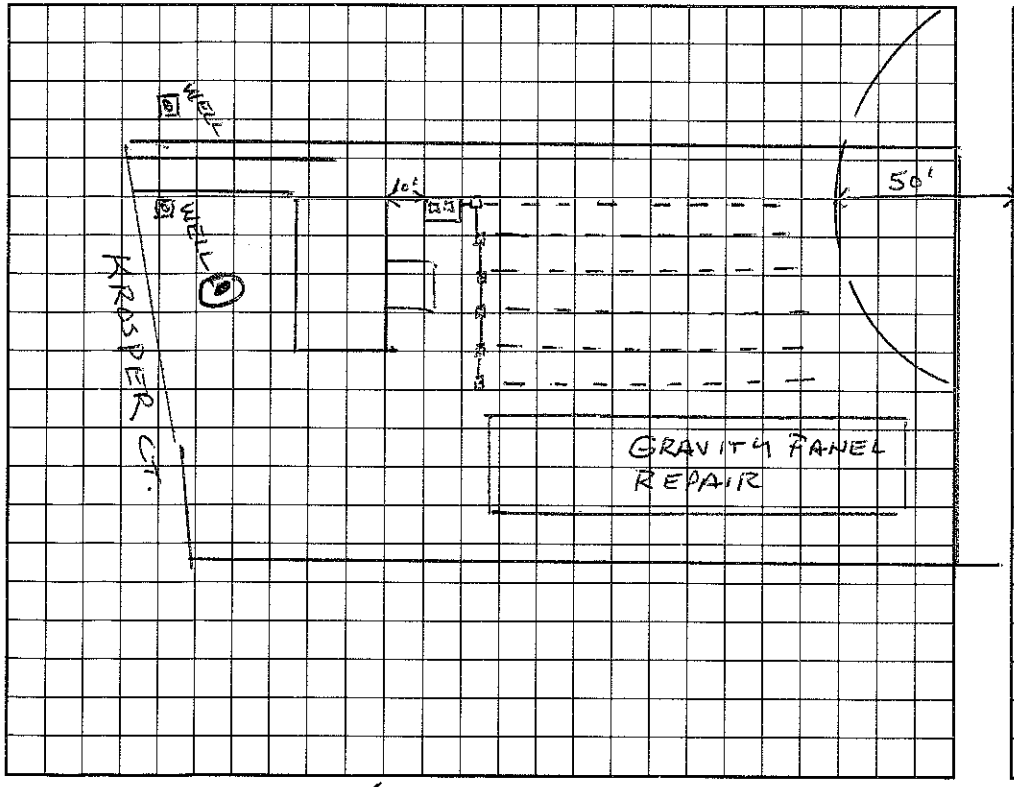

AS BUILT SKETCH

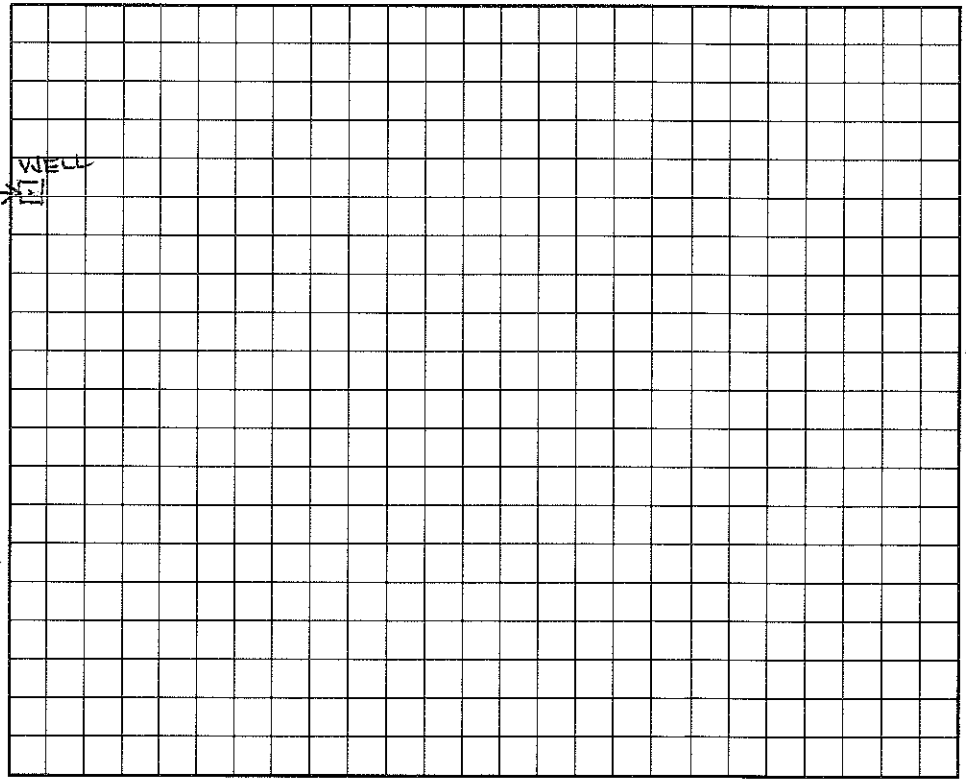

I understand that this permit can be suspended or revoked if any false information is supplied toward securing the permit/any unauthorized changes are made to the site/any unauthorized changes are made in the installation of the system. Improvement Permit is valid for 60 months from date of issuance.

Signed: _____

Improvement Permit by: Wesley Sparks R.S. date 3/13/95

Existing System Inspection by: _____ date _____

Installed by: Rowan Septic Tank

Certificate of Completion by: Wesley Sparks R.S. date 7/24/95

Operation Permit by: _____ date _____

HEALTH DEPT. COPY: WHITE INSPECTION COPY (FINAL): GREEN OWNER COPY (FINAL): YELLOW INSPECTION COPY (INITIAL): PINK OWNER COPY (INITIAL): GOLD