IREDELL COUNTY HEALTH DEPARTMENT

STATESVILLE 704-878-5305 MOORESVILLE 704-664-5281

IMPROVEMENT PERMIT / CERTIFICATE OF COMPLETION / OPERATION PERMIT / EXISTING SYSTEM INSPECTION

PROPERTY DESCRIPTION NO. 16388 DATE 1/13/94 TAX MAP NO. 25 7A2 Watershed: ☐ Yes ☑ No

OWNER OR CONTRACTOR Spear Const. Co. PHONE: Business 636-7954 ~~Home~~ 464-18-6235

ADDRESS 607 Anderson Ave Salisbury, NC 28144

LOCATION Mills Forest Ln. (R) off Cornelius Rd, to 2nd lot on (R) above road

SUBDIVISION Mills Forest BLOCK / SECTION 1 LOT 2 LOT AREA ~.5 AC SITE CLASS. P DESIGN FLOW 360 L.T.A. 25÷3

Septic Tank: 1000 Gallons; STB 325 Date 1-7-94

Pump Tank: _____ Gallons; PT _____ Date _____

Pump Make: _____ Model _____ Serial No. _____

Nitrification Field: No Fields 1 Square Feet 1200 Linear Feet 2107

No Lines 3 Trench Width 2' Max Trench Bottom Depth 36" Gravel Depth 6" SAND

☑ New System ☐ Repair System Type: I, II, (III) IV, V, VI

System Description: PPBAS 16" - DIST. BOX

Repair System Description: SAME

Maintenance Agreement Required: ☐ Yes ☑ No

☑ House/Mod. Home No. Bedrooms 3

☐ Mobile Home No. Bathrooms 2

☐ Business No. Employees ____


☐ Other _____

☐ Slab ☑ Crawl Space ☐ Basement w/plumbing ☐ Basement wo/plumbing

Water Supply: ☑ Individual ☐ Community ☐ Public


Comments: * 16" Psych Panel Blocks
MAXIMUM TRENCH BOTTOM 36"
CONTOURS IMPORTANT

INITIAL SITE SKETCH

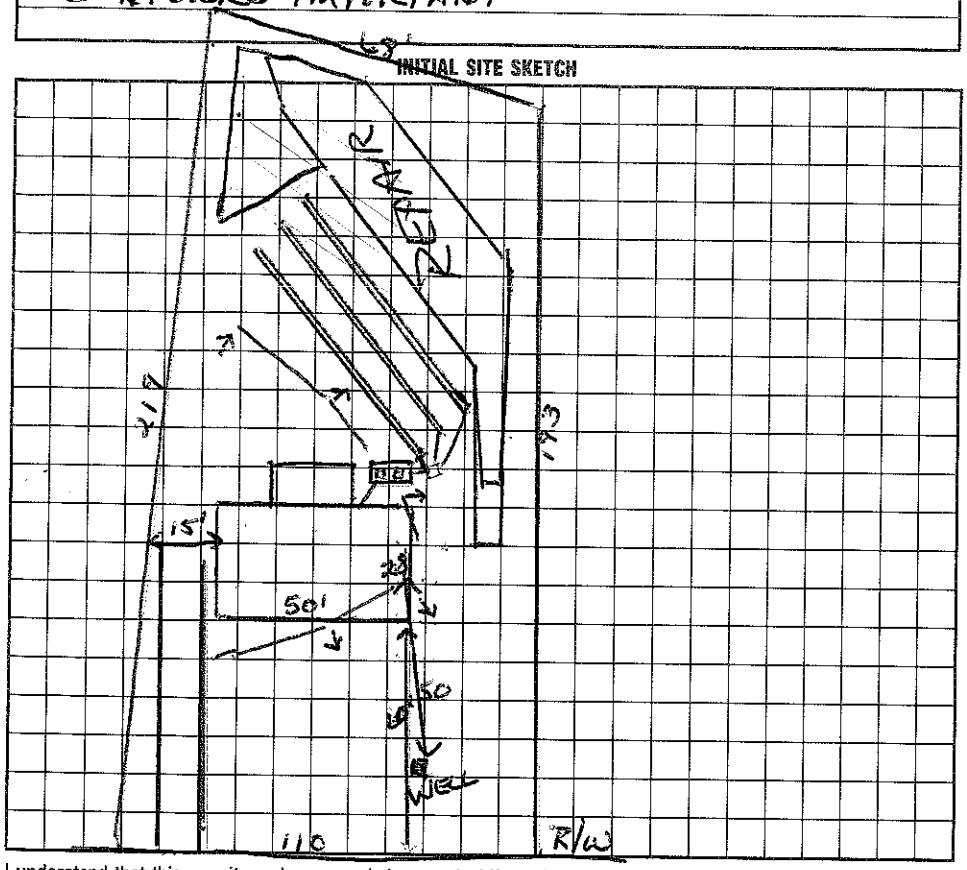

Comments:

AS BUILT SKETCH

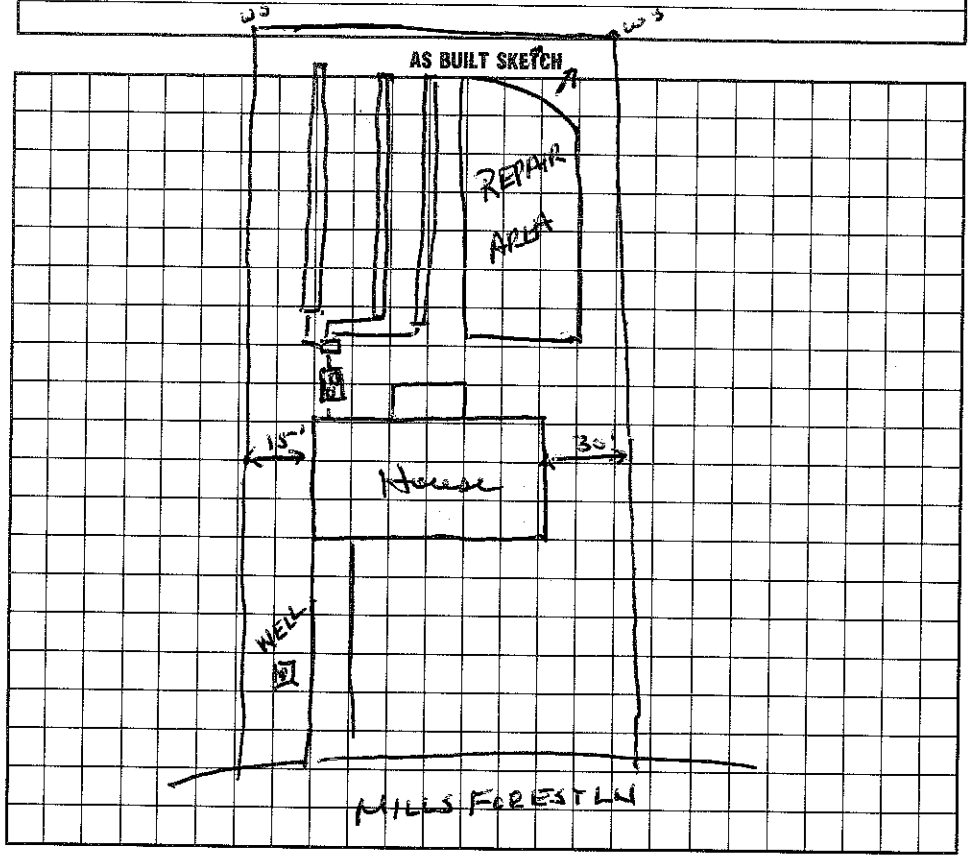

I understand that this permit can be suspended or revoked if any false information is supplied toward securing the permit/any unauthorized changes are made to the site/any unauthorized changes are made in the installation of the system. Improvement Permit is valid for 60 months from date of issuance.

Signed: _____

Improvement Permit by: Wesley Sparks RS. date 1/13/94

Existing System Inspection by: _____ date _____

Installed by: Rowan Septic Tank

Certificate of Completion by: Wesley Sparks RS. date 4/4/94

Operation Permit by: _____ date _____

HEALTH DEPT. COPY: WHITE INSPECTION COPY (FINAL): GREEN OWNER COPY (FINAL): YELLOW INSPECTION COPY (INITIAL): PINK OWNER COPY (INITIAL): GOLD