IREDELL COUNTY HEALTH DEPARTMENT

STATESVILLE 704-878-5305 MOORESVILLE 704-664-5281

IMPROVEMENT PERMIT / CERTIFICATE OF COMPLETION / OPERATION PERMIT / EXISTING SYSTEM INSPECTION

PROPERTY DESCRIPTION NO. 16381 DATE 8/27/93 TAX MAP NO. 25-7-A-3

OWNER OR CONTRACTOR SPEAR CONST. INC. PHONE: Business 4648-18-6325 Home 636-7954

ADDRESS 607 ANDERSON AVE. SALISBURY, NC. 28144

LOCATION CORNELIUS RD, TR. TO LOT ON (R) BEFORE CREST OF HILL

SUBDIVISION MILLS FOREST BLOCK / SECTION — LOT 3 LOT AREA 0.50 ACRE SITE CLASS. P L.T.A.R. 0.3

Water Supply: ☑ Individual ☐ Community ☐ Public

Septic Tank: 1000 Gallons; STB 825 Date 9/21/93

Pump Tank: _____ Gallons; PT _____ Date _____

Nitrification Field: No. Fields 1 Square Feet 1260 Linear Feet 400

No Lines 3 Trench Width ~~2'~~ 3' Trench Depth 36" Gravel Depth 12"

☑ New System ☐ Repair System Type: I, (II), III, IV, V, VI

System Description: CONV.

Repair System Description: CONV.-REPAIR

Maintenance Agreement Required: ☐ Yes ☑ No

☑ House/Mod. Home ☐ Mobile Home ☐ Business ☐ Other

No. Bedrooms 3 No. Bathrooms 2 No. Employees _____

Garbage Disposal: ☐ Yes ☑ No

Auto. Dishwasher: ☑ Yes ☐ No


Auto. Washing Machine: ☑ Yes ☐ No

Other _____

☐ Slab ☑ Crawl Space ☐ Basement w/plumbing ☐ Basement wo/plumbing

Comments KEEP TRENCHES SHALLOW NO DEEPER THAN 32" TO TRENCH BOTTOM. LINES ON SLOPE CONTOUR IN DIRECTION SHOWN

INITIAL SITE SKETCH

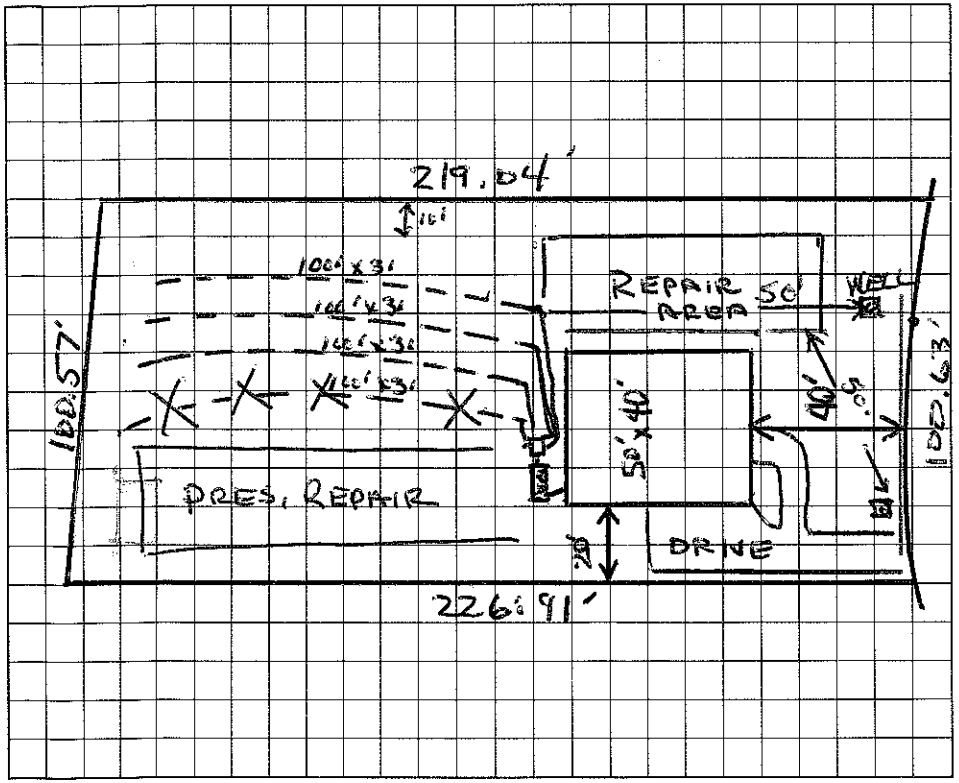

AS BUILT SKETCH

Installed as drawn 11/3/93 AWS

I understand that this permit can be suspended or revoked if any false information is supplied toward securing the permit/any unauthorized changes are made to the site/any unauthorized changes are made in the installation of the system. Improvement Permit is valid for 60 months from date of issuance.

Signed: _____

Improvement Permit by: Wesley Sparks RS. date 8/27/93

Existing System Inspection by: _____ date _____

Installed by: Rowen Septic Tank

Certificate of Completion by: Wesley Sparks R.S. date 11/3/93

Operation Permit by: _____ date _____

HEALTH DEPT. COPY: WHITE INSPECTION COPY (FINAL): GREEN OWNER COPY (FINAL): YELLOW INSPECTION COPY (INITIAL): PINK OWNER COPY (INITIAL): GOLD