IREDELL COUNTY HEALTH DEPARTMENT

STATESVILLE 704-878-5305 MOORESVILLE 704-664-5281

IMPROVEMENT PERMIT / CERTIFICATE OF COMPLETION / OPERATION PERMIT / EXISTING SYSTEM INSPECTION

PROPERTY DESCRIPTION NO. 16382 DATE ~~august 13, 1993~~ TAX MAP NO. 25-7-A-4

OWNER OR CONTRACTOR Spear Construction, Inc. PHONE: Business 704 636 7954 Home

ADDRESS 607 Anderson Avenue, Salisbury, NC 28144 4048-18-6406

LOCATION ~~on north side of cornelius road aPPROX X$X .4 mile west of judas road~~

SUBDIVISION Mills Forest BLOCK / SECTION LOT 4 LOT AREA ~~20,000 sq ft~~ SITE CLASS. P L.T.A.R. 0.3

Water Supply: [X] Individual [ ] Community [ ] Public

Septic Tank: 1000 Gallons; STB 925 Date 11/1/93

Pump Tank: 0 Gallons; PT Date

Nitrification Field: No Fields 1 Square Feet 1200 Linear Feet 400

5 No Lines ~~ARRADEE~~ Trench Width 36" Trench Depth 24" Gravel Depth 12"

[X] New System [ ] Repair System Type: I, (II), II, IV, V, VI

System Description: ~~gravity conventional~~

Repair System Description: grav conv/PPBPS

Maintenance Agreement Required: [ ] Yes [ ] No

[X] House/Mod. Home No. Bedrooms 3,2 Garbage Disposal: XXXX [ ] No

[ ] Mobile Home No. Bathrooms 2 Auto. Dishwasher: [✓] Yes [ ] No


[ ] Business No. Employees Auto. Washing Machine: [✓] Yes [ ] No

[ ] Other Other

[ ] Slab [✓] Crawl Space [ ] Basement w/plumbing [ ] Basement wo/plumbing

Comments ~~do not install during wet soil conditions or rain. install on contour. contact dept if any questions about layout. maintain 10' setback to property lines and foundation.~~ * NOTICE HOUSE SETBACKS ON DIAGRAM.

INITIAL SITE SKETCH

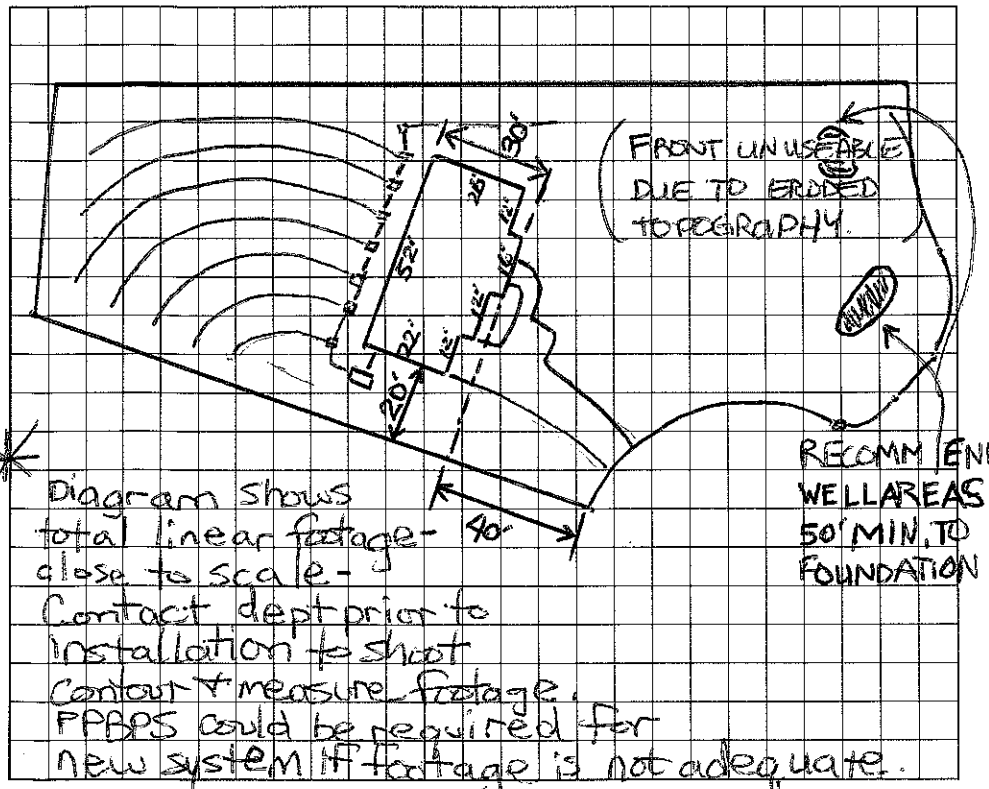

* Diagram shows total linear footage - close to scale - Contact dept prior to installation to shoot contour & measure footage. PPBPS could be required for new system if footage is not adequate.

AS BUILT SKETCH

I understand that this permit can be suspended or revoked if any false information is supplied toward securing the permit/any unauthorized changes are made to the site/any unauthorized changes are made in the installation of the system. Improvement Permit is valid for 60 months from date of issuance.

Signed:

Improvement Permit by: Andrea Lemon date 8-23-93

Existing System Inspection by: date

Installed by: Rowan Septic Tank

Certificate of Completion by: Wesley Sparks R.S. date 12/28/93

Operation Permit by: date

HEALTH DEPT. COPY: WHITE INSPECTION COPY (FINAL): GREEN OWNER COPY (FINAL): YELLOW INSPECTION COPY (INITIAL): PINK OWNER COPY (INITIAL): GOLD