IREDELL COUNTY HEALTH DEPARTMENT

STATESVILLE 704-878-5305 MOORESVILLE 704-664-5281

IMPROVEMENT PERMIT / CERTIFICATE OF COMPLETION / OPERATION PERMIT / EXISTING SYSTEM INSPECTION

PROPERTY DESCRIPTION NO. 16171 DATE 7/13/93 TAX MAP NO. 25 7A 5

OWNER OR CONTRACTOR SPEAR CONST CO. PHONE: Business 636-7954 ~~Home~~ 4648-18-7516

ADDRESS

LOCATION CORNELIUS RD X LAKE TR, 1ST R, LOT ON (R) OFF and of cul de sac

SUBDIVISION MILLS FOREST BLOCK / SECTION LOT 5 LOT AREA ~ 20,000 FT² SITE CLASS. P L.T.A.R. .3

Water Supply: ☑ Individual ☐ Community ☐ Public

Septic Tank: 1000 Gallons; STB 825 Date 5-5-93

Pump Tank: Gallons; PT Date

Nitrification Field: No Fields 1 Square Feet ~~450~~ 120 Linear Feet 400

No Lines 5 Trench Width 36" Trench Depth 24" Gravel Depth 12"

☑ New System ☐ Repair System Type: I (II) III, IV, V, VI

System Description: CONV

Repair System Description: PRESS/PANEL 16"

Maintenance Agreement Required: ☐ Yes ☑ No

☑ House/Mod. Home No. Bedrooms 3 Garbage Disposal: ☐ Yes ☑ No

☐ Mobile Home No. Bathrooms 2 Auto. Dishwasher: ☑ Yes ☐ No

☐ Business No. Employees Auto. Washing Machine: ☑ Yes ☐ No


☐ Other Other

☐ Slab ☑ Crawl Space ☐ Basement w/plumbing ☐ Basement wo/plumbing

Comments PRESSURE REPAIR AREA - PANELS

INITIAL SITE SKETCH

AS BUILT SKETCH

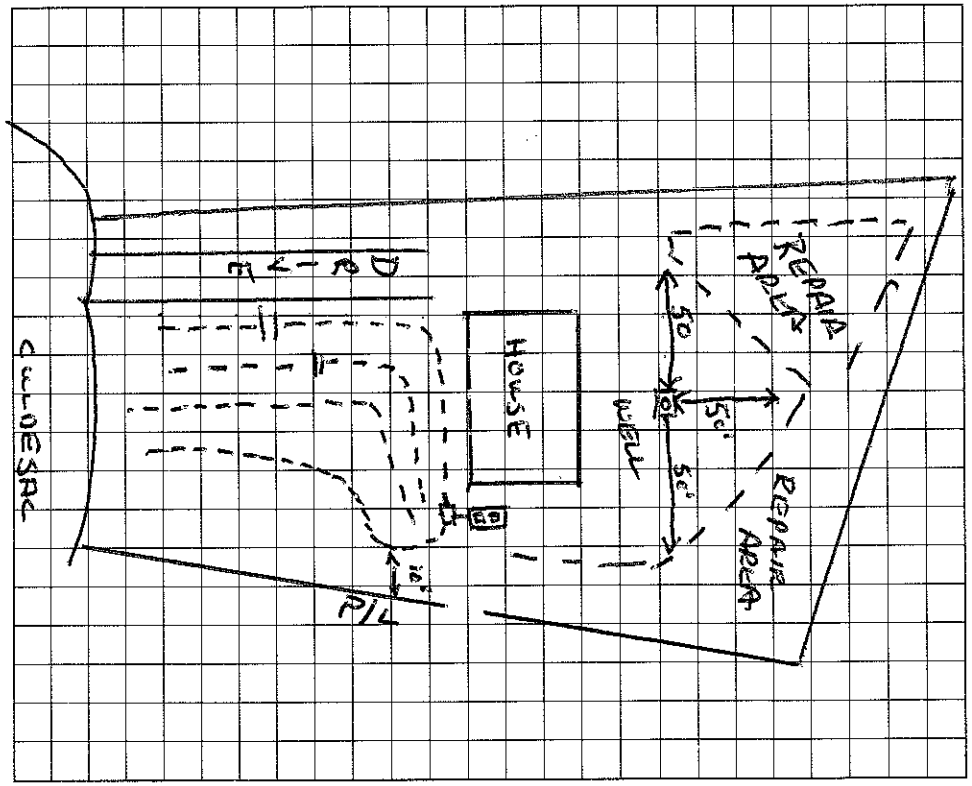

I understand that this permit can be suspended or revoked if any false information is supplied toward securing the permit/any unauthorized changes are made to the site/any unauthorized changes are made in the installation of the system. Improvement Permit is valid for 60 months from date of issuance.

Signed:

Improvement Permit by: date

Existing System Inspection by: date

Installed by: ROWAN SEPTIC TANK CO.

Certificate of Completion by: Wesley Sparks. date 7/13/93

Operation Permit by: date

HEALTH DEPT. COPY: WHITE INSPECTION COPY (FINAL): GREEN OWNER COPY (FINAL): YELLOW INSPECTION COPY (INITIAL): PINK OWNER COPY (INITIAL): GOLD