IREDELL COUNTY HEALTH DEPARTMENT

STATESVILLE 704-878-5305 MOORESVILLE 704-664-5281

IMPROVEMENT PERMIT / CERTIFICATE OF COMPLETION / OPERATION PERMIT / EXISTING SYSTEM INSPECTION

PROPERTY DESCRIPTION NO. 17227 DATE 3-9-94 TAX MAP NO. 25 A 51

OWNER OR CONTRACTOR Krom Financial Services PHONE: Business 664-3671 Home

ADDRESS ~~XXXX~~ 19 Yacht Cove Mooresville NC 28115

LOCATION ~~north side of Cornelius road west of Judas road~~ 4648-18-7814

SUBDIVISION ~~Mills Forest~~ BLOCK / SECTION TT LOT 5 LOT AREA 20,000 SITE CLASS. D L.T.A.R. 0.25

Water Supply: ☒ Individual ☐ Community ☐ Public

Septic Tank: 1000 Gallons; STB 825 Date 1/27/95

Pump Tank: na Gallons; PT Date

Nitrification Field: No Fields 1 Square Feet 1440 Linear Feet 480

No Lines 5 Trench Width 36" Trench Depth 20" Gravel Depth 12"

☒ New System ☐ Repair System Type: I, (II), II, IV, V, VI

System Description: gravity conventional

Repair System Description: ~~low-pressure pipe~~

Maintenance Agreement Required: ☐ Yes ☒ No

☒ House/Mod. Home No. Bedrooms 3

☐ Mobile Home No. Bathrooms 3

☐ Business No. Employees

☐ Other

☐ Slab ☒ Crawl Space ☐ Basement w/plumbing ☐ Basement wo/plumbing

Garbage Disposal: ☐ Yes ☒ No


Auto. Dishwasher: ☒ Yes ☐ No

Auto. Washing Machine: ☐ Yes ☐ No

Other

Comments ~~Do not install during wet soil conditions or rain.~~


INITIAL SITE SKETCH

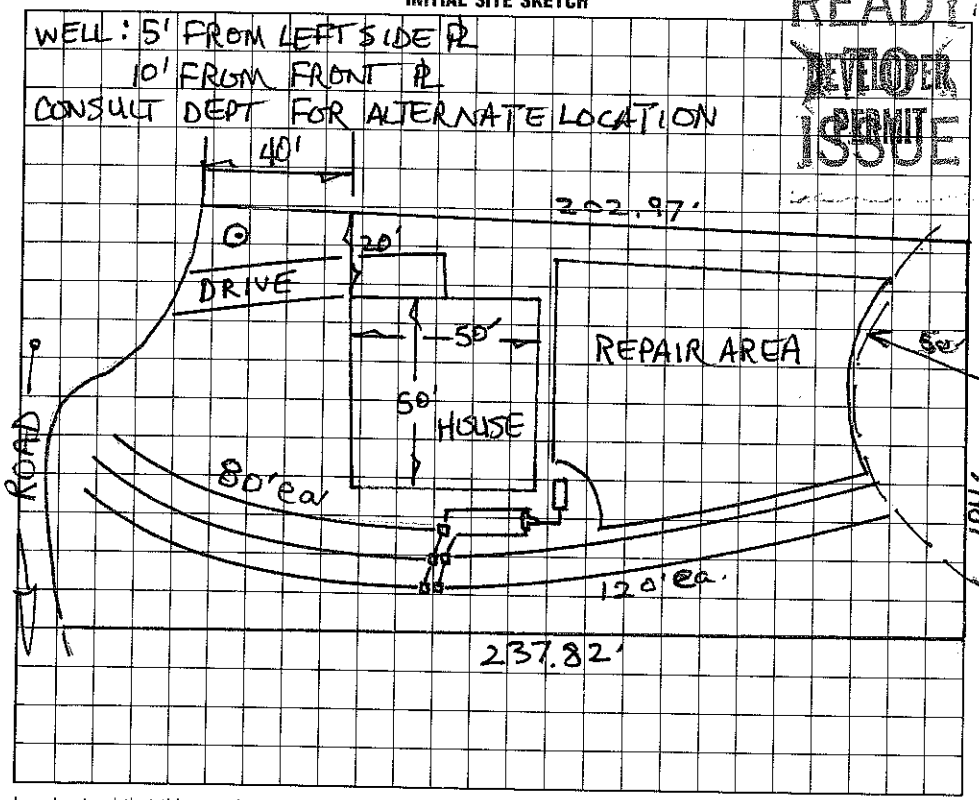

READY 12/5/94 Aug

DEVELOPER PERMIT ISSUE

AS BUILT SKETCH

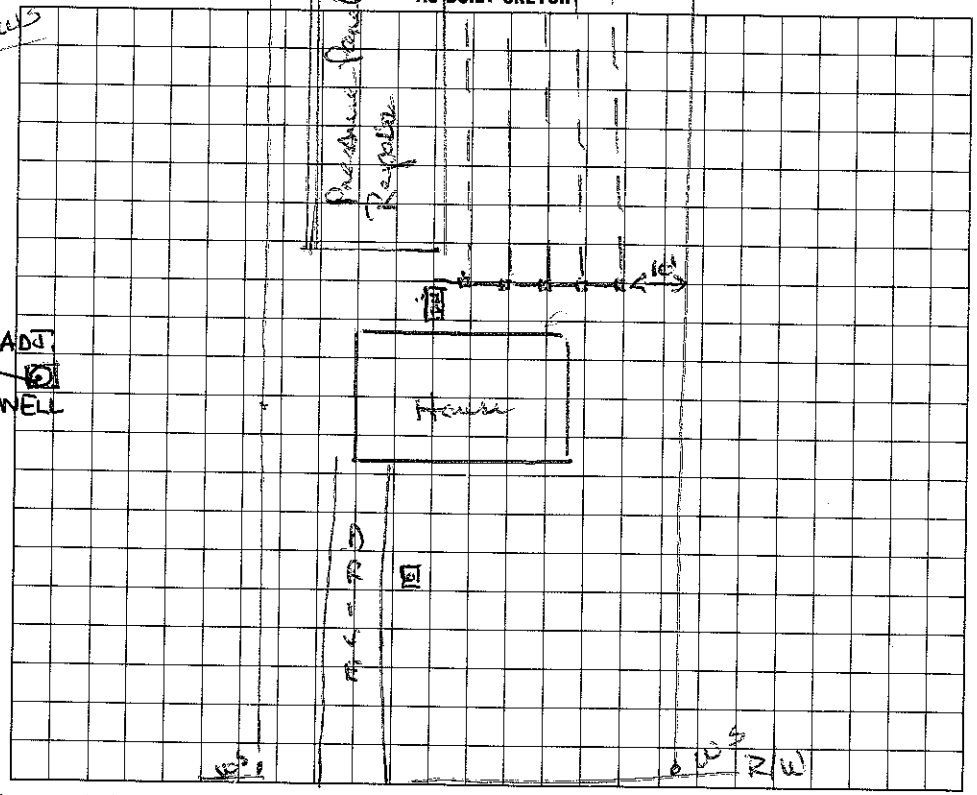

I understand that this permit can be suspended or revoked if any false information is supplied toward securing the permit/any unauthorized changes are made to the site/any unauthorized changes are made in the installation of the system. Improvement Permit is valid for 60 months from date of issuance.

Signed:

Improvement Permit by: Andrea Lemon date 3.9.94

Existing System Inspection by: date

Installed by: Rawson Septic Tank

Certificate of Completion by: Wesley Sparkes date 4/17/95

Operation Permit by: date

HEALTH DEPT. COPY: WHITE INSPECTION COPY (FINAL): GREEN OWNER COPY (FINAL): YELLOW INSPECTION COPY (INITIAL): PINK OWNER COPY (INITIAL): GOLD