IREDELL COUNTY HEALTH DEPARTMENT

STATESVILLE 704-878-5305 MOORESVILLE 704-664-5281

IMPROVEMENT PERMIT / CERTIFICATE OF COMPLETION / OPERATION PERMIT / EXISTING SYSTEM INSPECTION

PROPERTY DESCRIPTION NO. 17328 DATE 3-10-94 TAX MAP NO. 25 A 51 Watershed: ☐ Yes ☐ No

OWNER OR CONTRACTOR KROM FINANCIAL SERVICES PHONE: Business 664-3671 Home

ADDRESS 19 Yacht Cove Mooresville NC 28115

LOCATION ~~north side of cornelius road west of judas road~~ 4648-19-2703

SUBDIVISION mills forest BLOCK / SECTION XX II LOT ~~335~~ LOT AREA 20,000min SITE CLASS. P DESIGN FLOW 360 L.T.A.R. 0.25

Septic Tank: 1000 Gallons; STB 825 Date 7/9/94

Pump Tank: Gallons; PT Date

Pump Make: Model Serial No.

Nitrification Field: No Fields 1 Square Feet 1440 Linear Feet 480

No Lines 3 Trench Width 36" Max Trench Bottom Depth 20" Gravel Depth 12"

☒ New System ☐ Repair System Type: I, (II) III, IV, V, VI

System Description: gravity conventional

Repair System Description: grav/pump conventional

Maintenance Agreement Required: ☐ Yes ☒ No

☒ House/Mod. Home No. Bedrooms 3

☐ Mobile Home No. Bathrooms 2

☐ Business No. Employees

☐ Other

☐ Slab ☒ Crawl Space ☐ Basement w/plumbing ☐ Basement wo/plumbing


Water Supply: ☒ Individual ☐ Community ☐ Public

Comments: do not install during wet soil conditions or rain

READY DEVELOPER NO PERMIT ISSUE

Comments: 10/11/94 Installed essentially as shown on I. P.

INITIAL SITE SKETCH

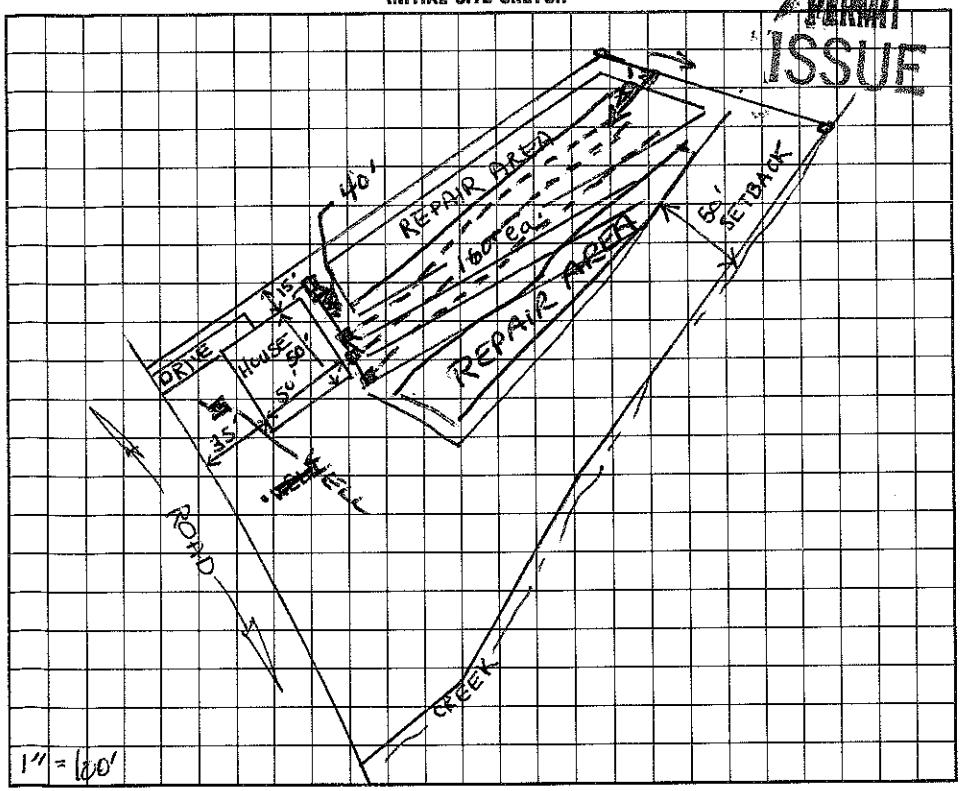

AS BUILT SKETCH

I understand that this permit can be suspended or revoked if any false information is supplied toward securing the permit/any unauthorized changes are made to the site/any unauthorized changes are made in the installation of the system. Improvement Permit is valid for 60 months from date of issuance.

Signed:

Improvement Permit by: Andrea Lemon date 3-11-94

Existing System Inspection by: date

Installed by: Roman Septic Tank

Certificate of Completion by: Wesley Sparks RS. date 10/11/94

Operation Permit by: date

HEALTH DEPT. COPY: WHITE INSPECTION COPY (FINAL): GREEN OWNER COPY (FINAL): YELLOW INSPECTION COPY (INITIAL): PINK OWNER COPY (INITIAL): GOLD